


Application No. 64111
Permit No. 48807

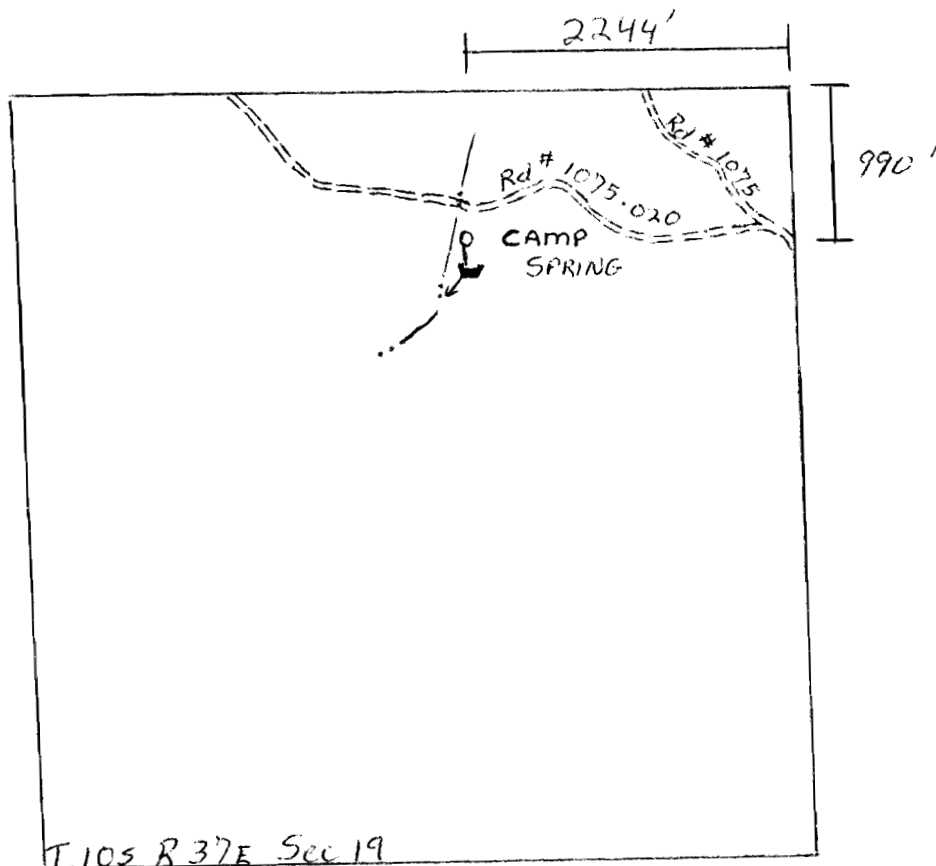

4" = 1 mile



RECEIVED
SEP 7 1982
WATER RESOURCES DEPT.
SALEM, OREGON