


Application No. 64112
Permit No. 48808

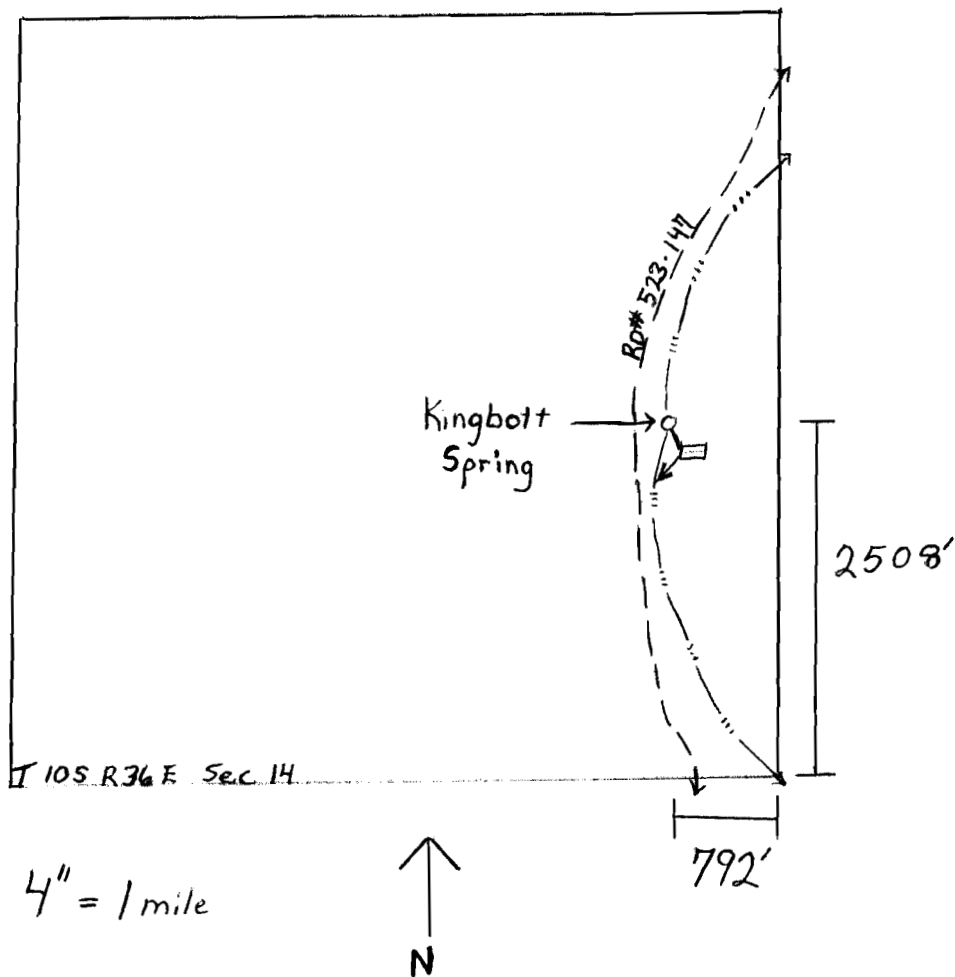

RECEIVED

SEP 7 1982

WATER RESOURCES DEPT.
SALEM, OREGON