


Application No. 64113
Permit No. 48809

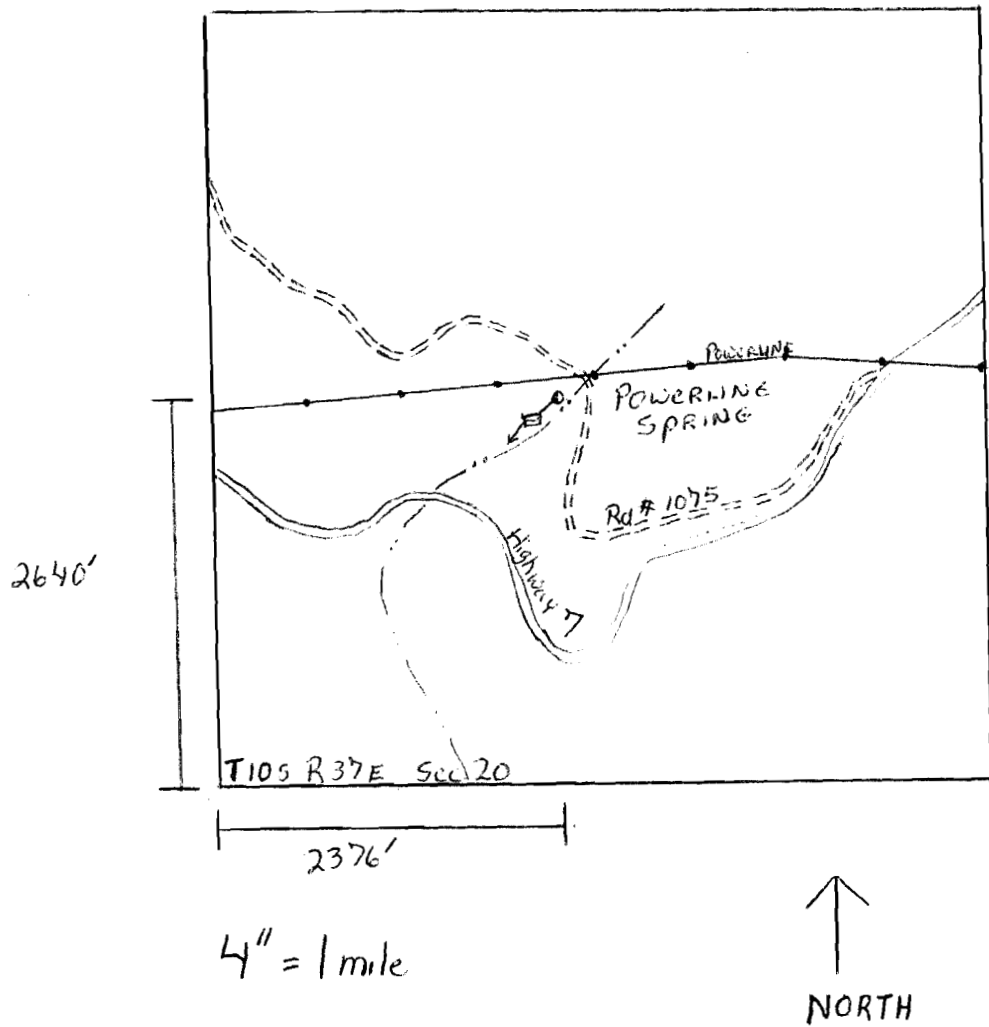

RECEIVED
SEP 7 1982
WATER RESOURCES DEPT.
SALEM, OREGON