


Application No. 64114
Permit No. 48810

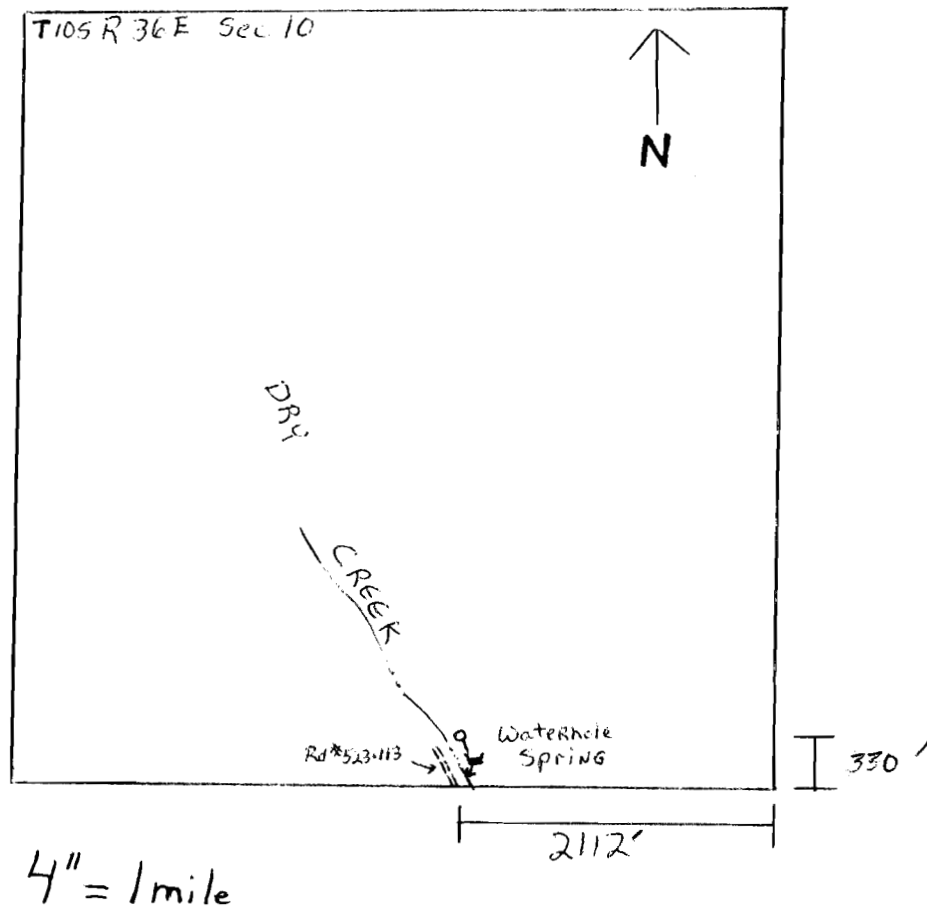

RECEIVED

SEP 7 1982

WATER RESOURCES DEPT.
SALEM, OREGON