


Application No. 64115
Permit No. 48811

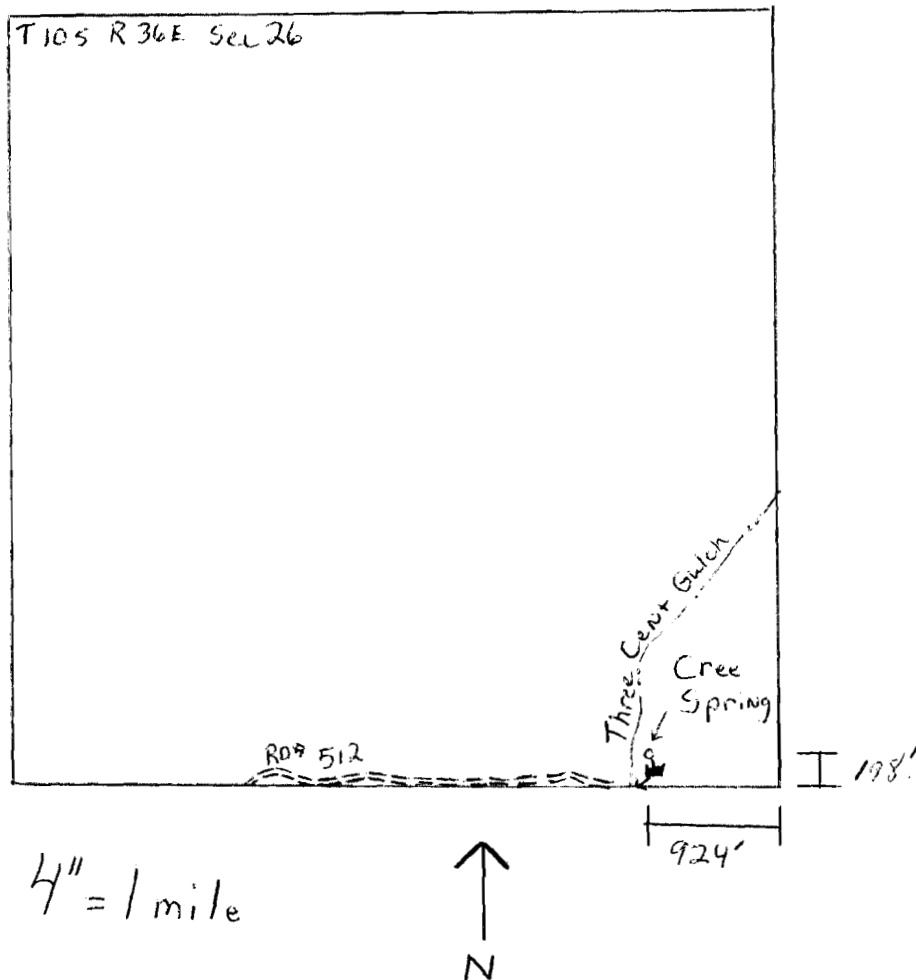

RECEIVED

SEP 7 1982

WATER RESOURCES DEPT.
SALEM, OREGON