


Application No. 64116
Permit No. 48812

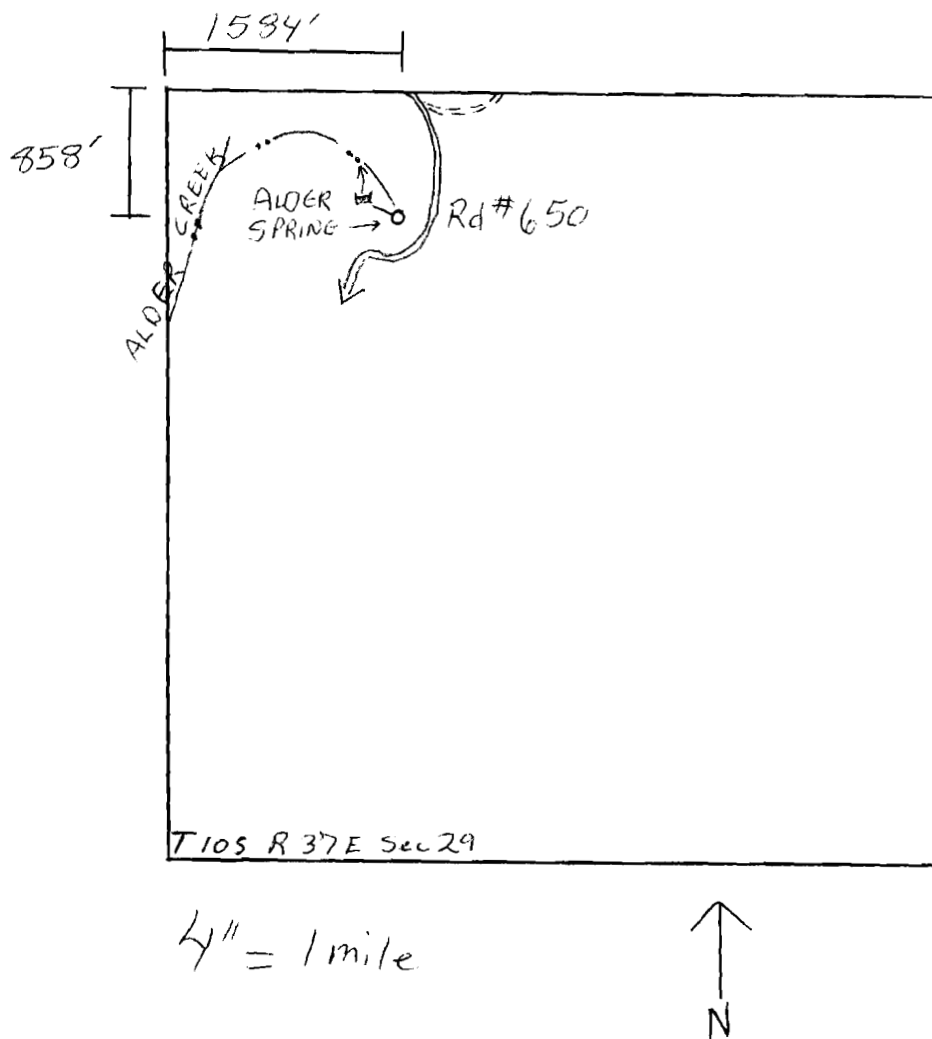

RECEIVED

SEP 7 1982

WATER RESOURCES DEPT.
SALEM, OREGON