


Application No. 64117
Permit No. 48813

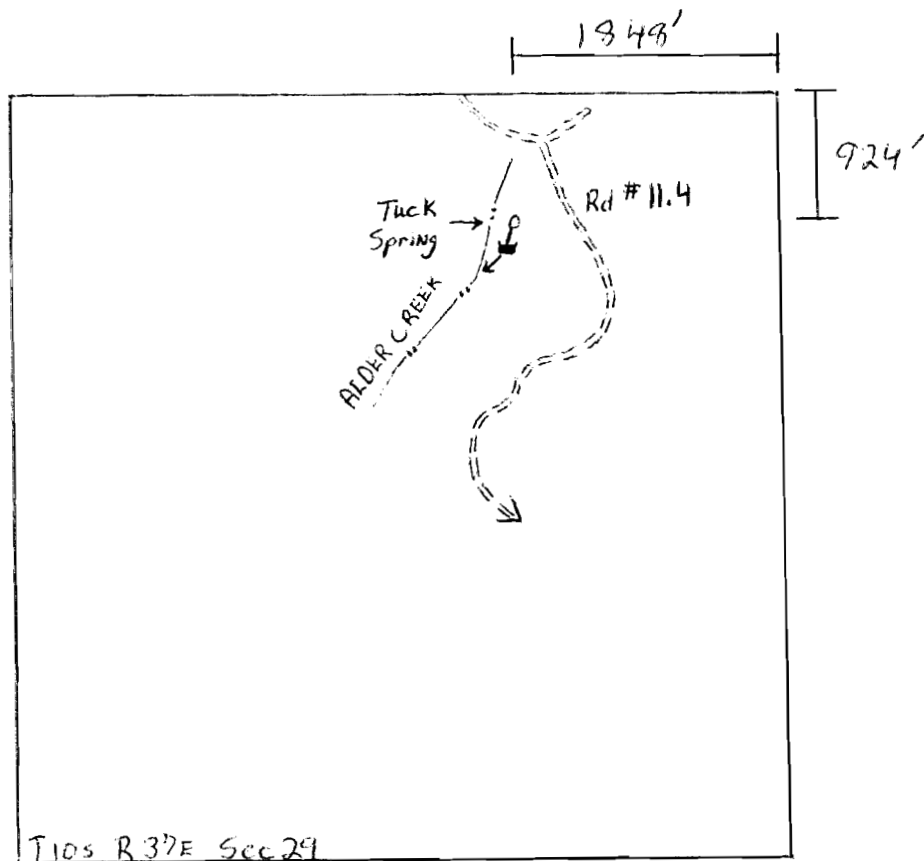

4" = 1 mile



RECEIVED
SEP 7 1982
WATER RESOURCES DEPT.
SALEM, OREGON