


Application No. 64118
Permit No. 48814

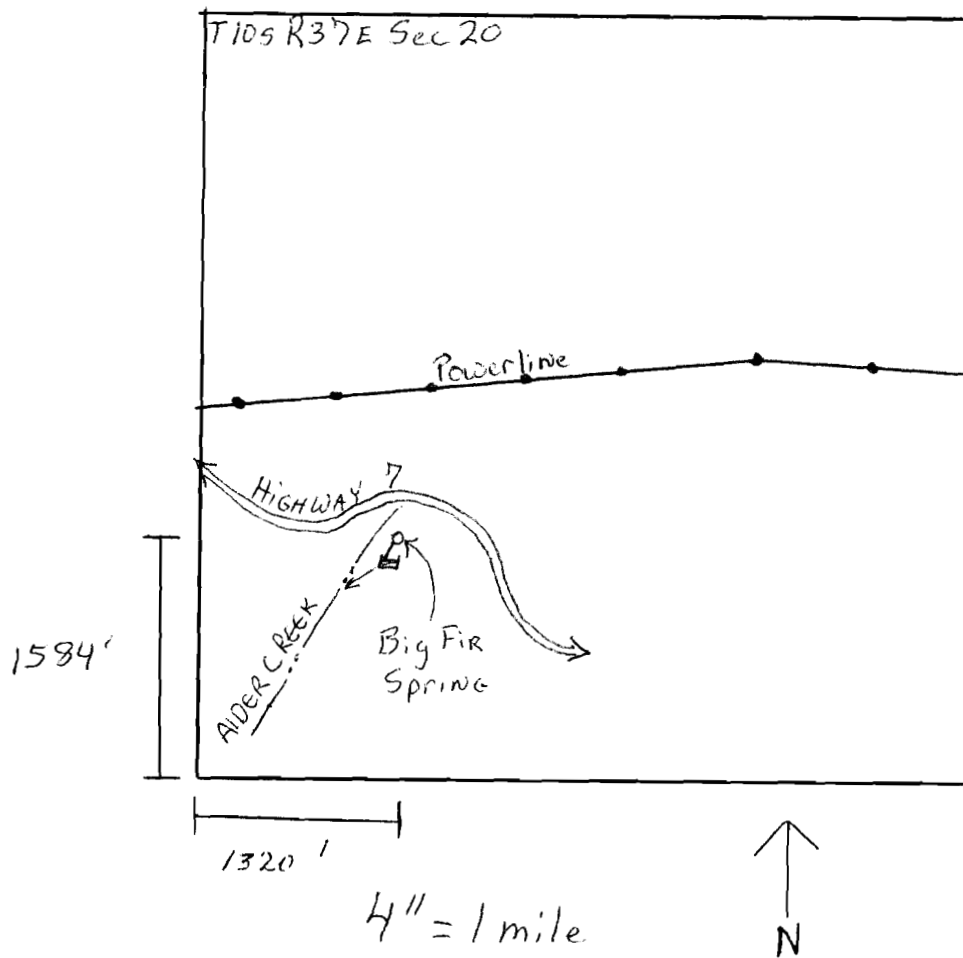

RECEIVED

SEP 7 1982

WATER RESOURCES DEPT.
SALEM, OREGON