


Application No. 64119
Permit No. 48815

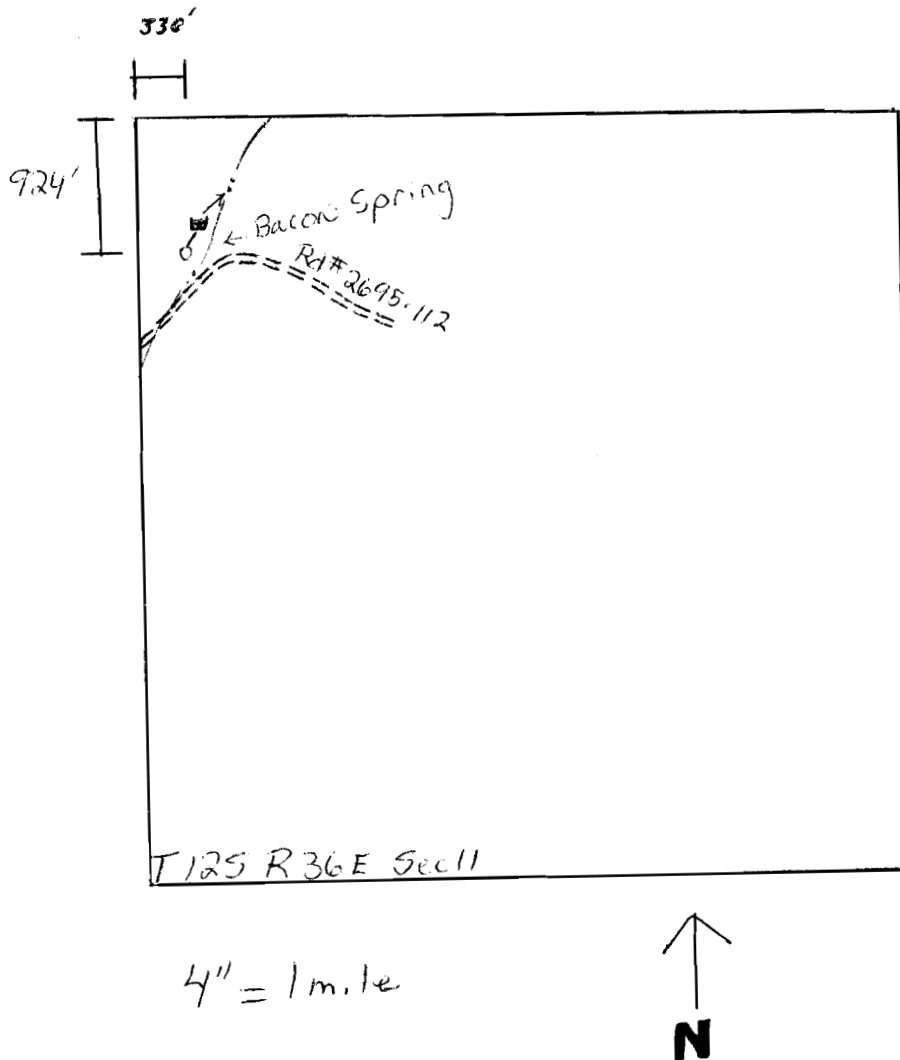

RECEIVED
SEP 7 1982
WATER RESOURCES DEPT.
SALEM, OREGON