


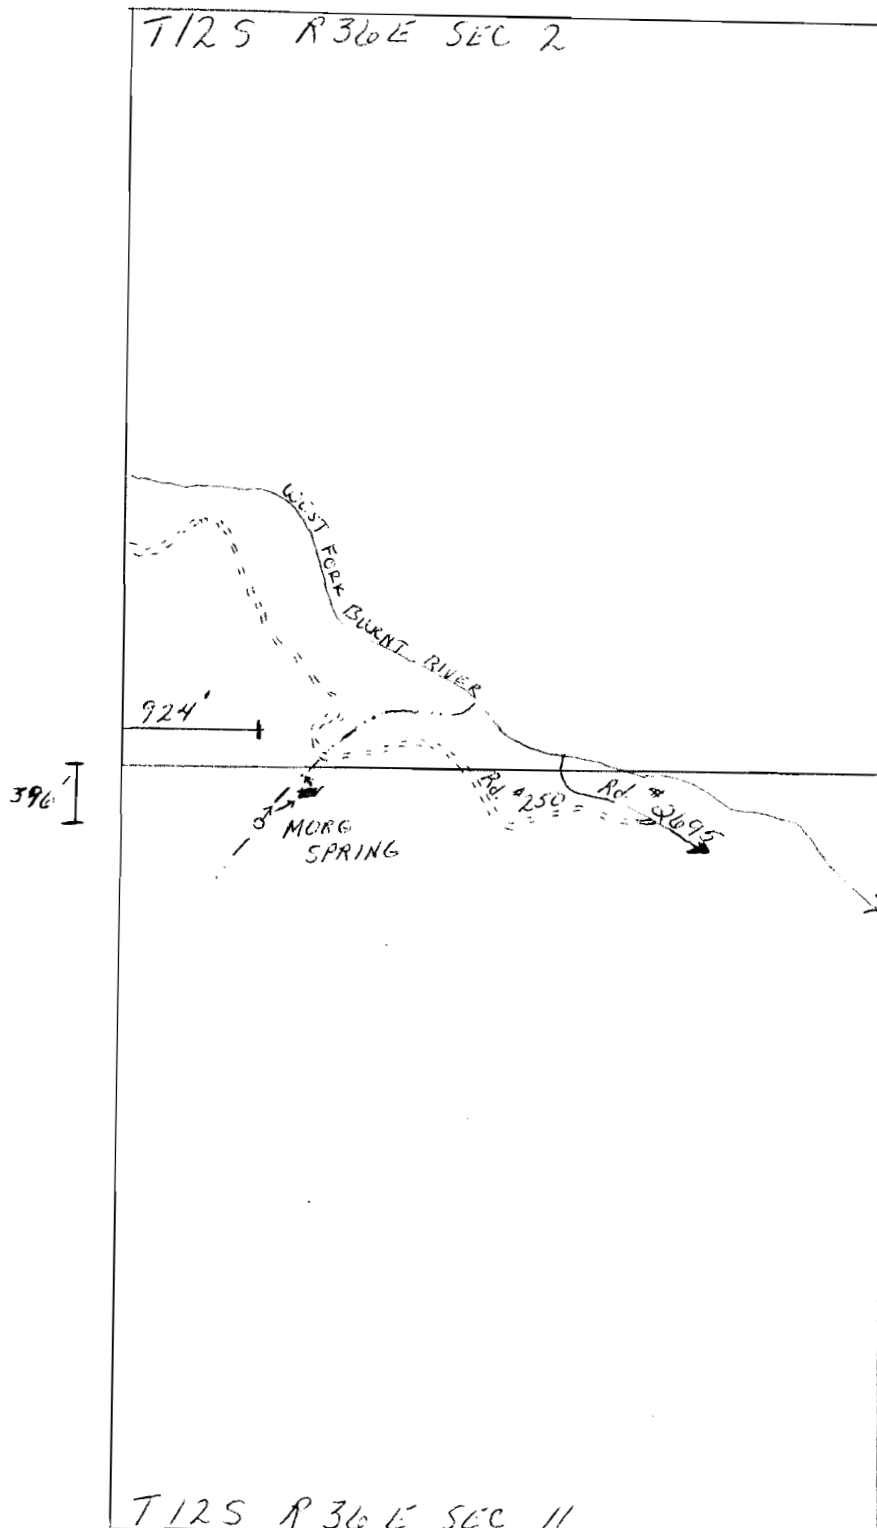

4" = 1 MILE



Application No. 64121
Permit No. 48817

RECEIVED
SEP 7 1982
WATER RESOURCES DEPT.
SALEM, OREGON