


Application No. 64122
Permit No. 48818

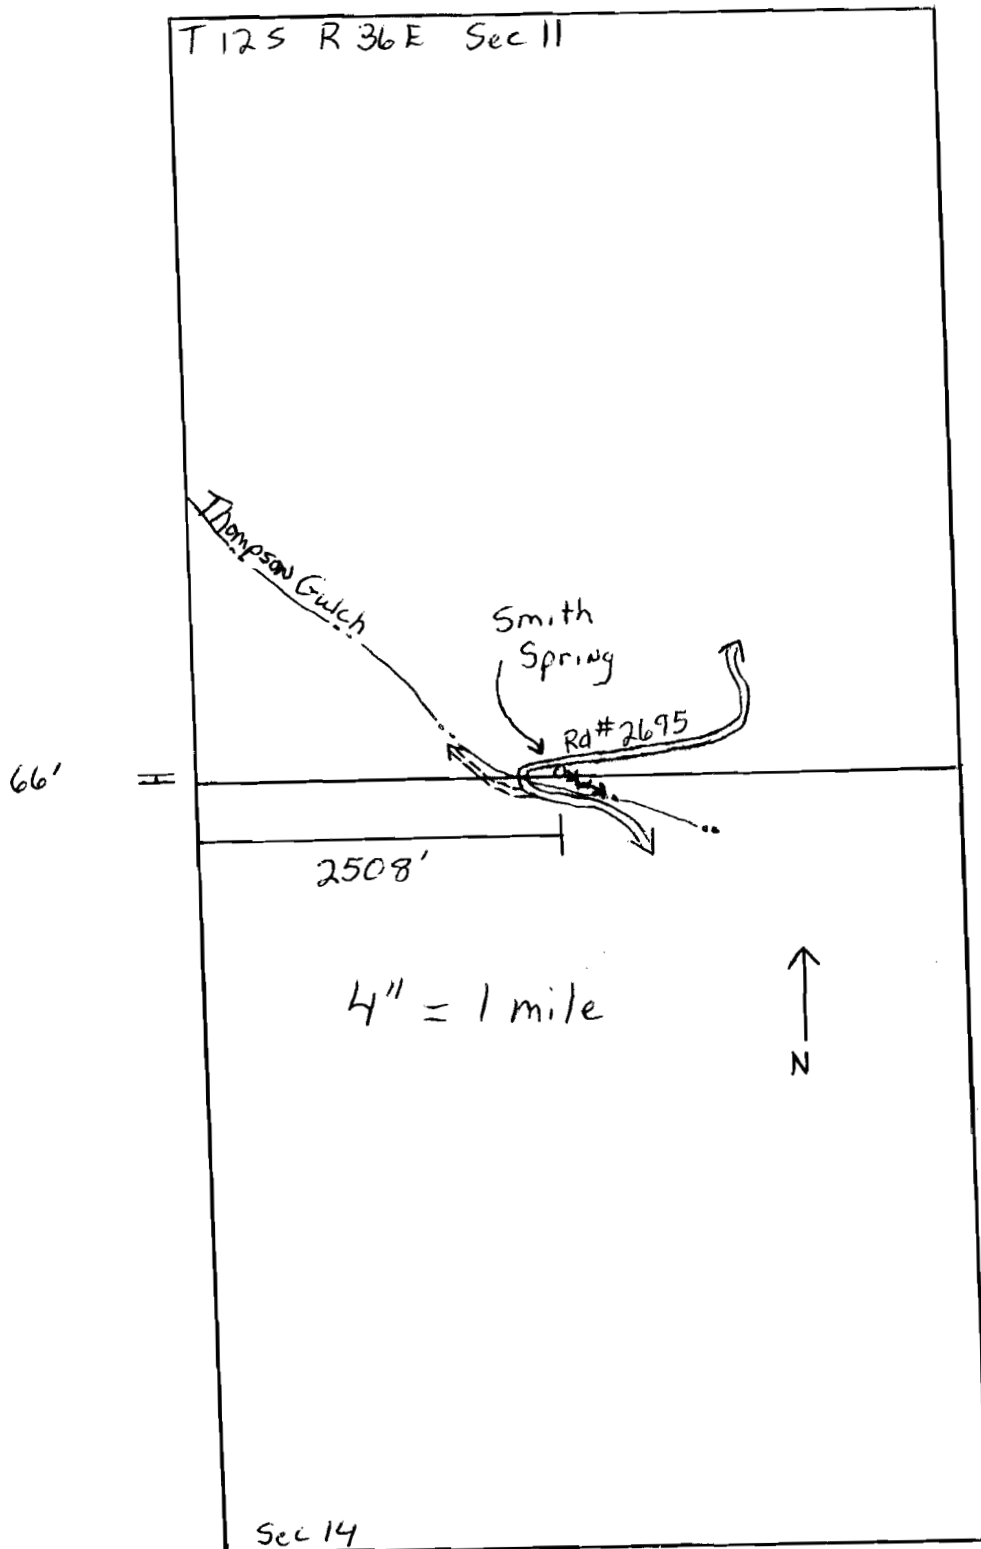

RECEIVED

MAR 24 1983

WATER RESOURCES DEPT.
SALEM, OREGON

RECEIVED

SEP 7 1982

WATER RESOURCES DEPT.
SALEM, OREGON