


Application No. 64123
Permit No. 48819

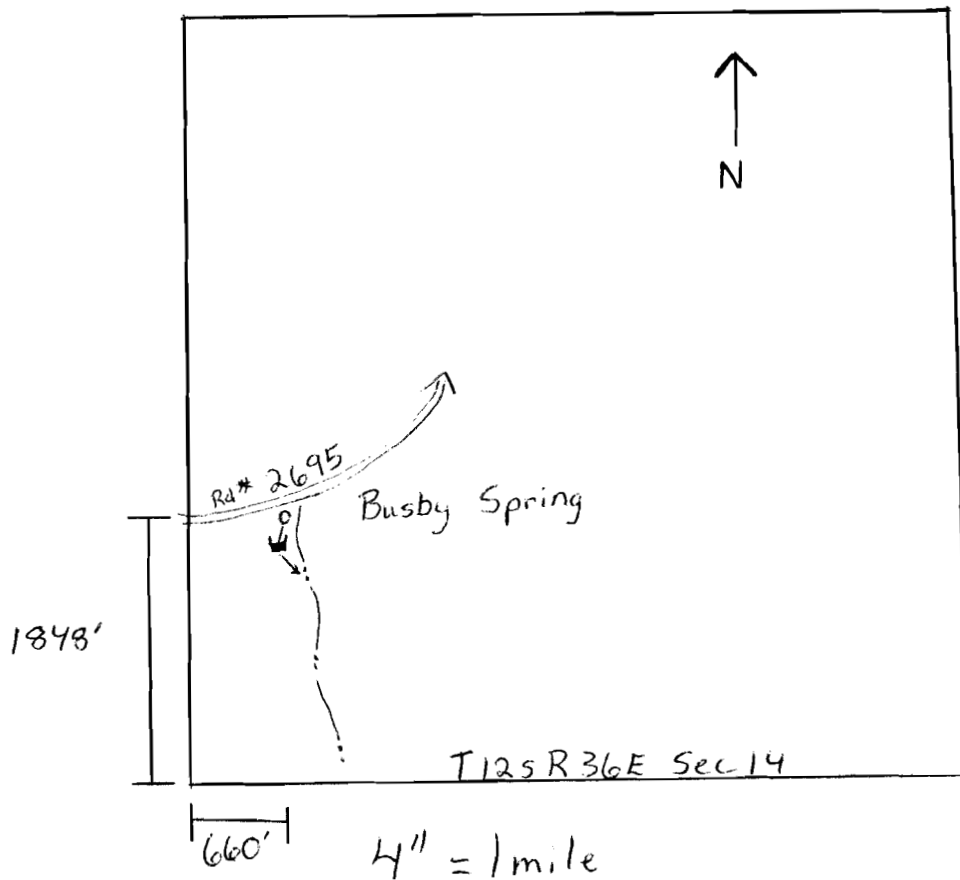

RECEIVED
SEP 7 1982
WATER RESOURCES DEPT.
SALEM, OREGON