


Application No. 64124
Permit No. 48820

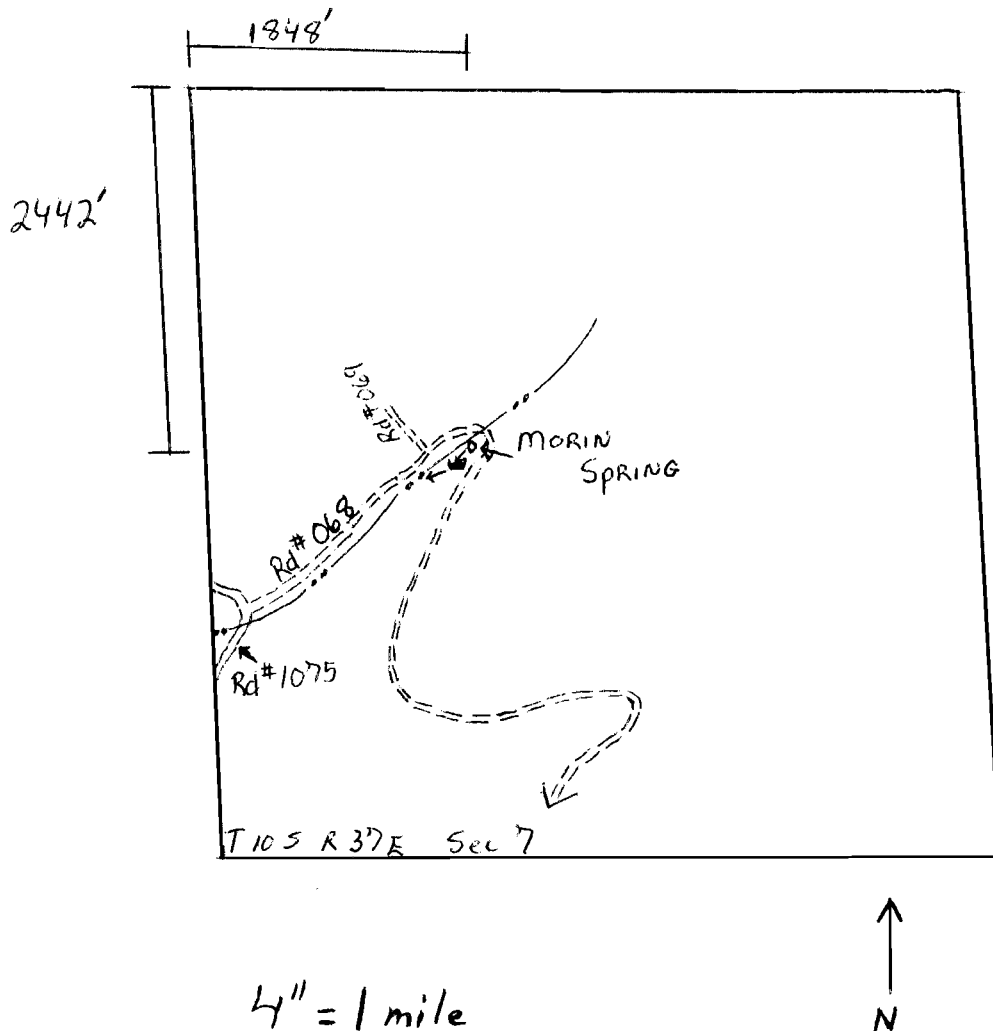

RECEIVED

SEP 7 1982

WATER RESOURCES DEPT.
SALEM, OREGON