


Application No. 64125
Permit No. 48821

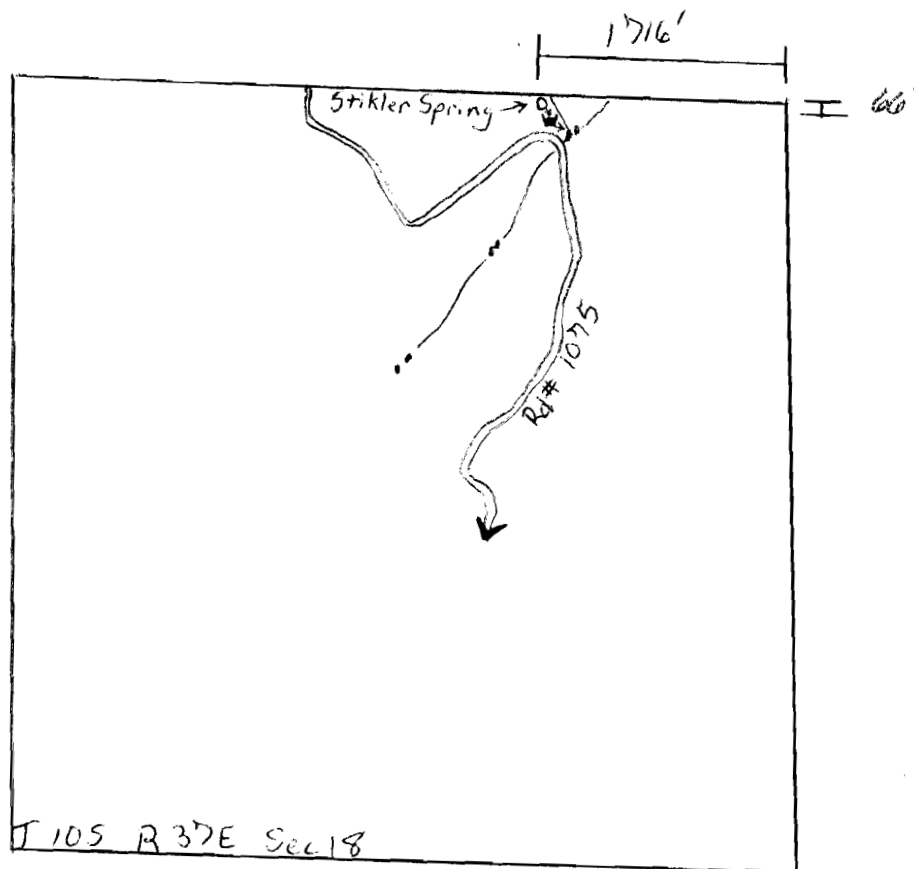

T 10S R 37E Sec 18

4" = 1 mile



RECEIVED

SEP 7 1982

WATER RESOURCES DEPT.
SALEM, OREGON