



Application No. 64126  
Permit No. 48822

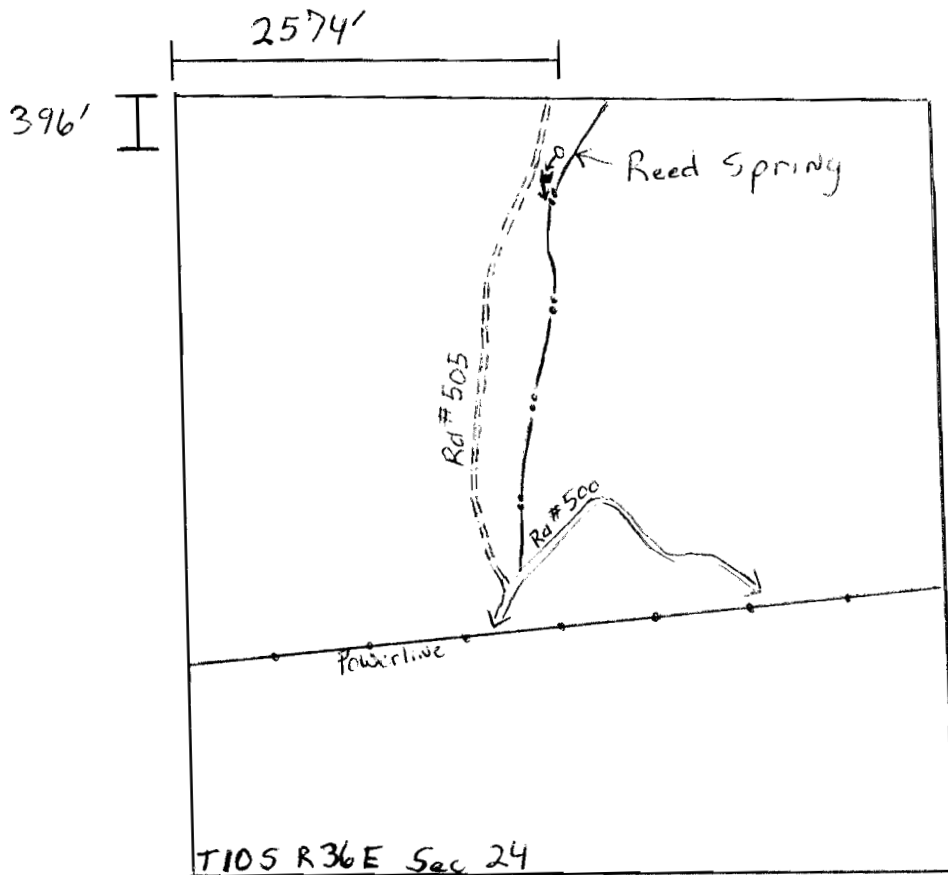

4" = 1 mile

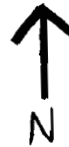

**RECEIVED**  
SEP 7 1982  
WATER RESOURCES DEPT.  
SALEM, OREGON