


Application No. 64127
Permit No. 48823

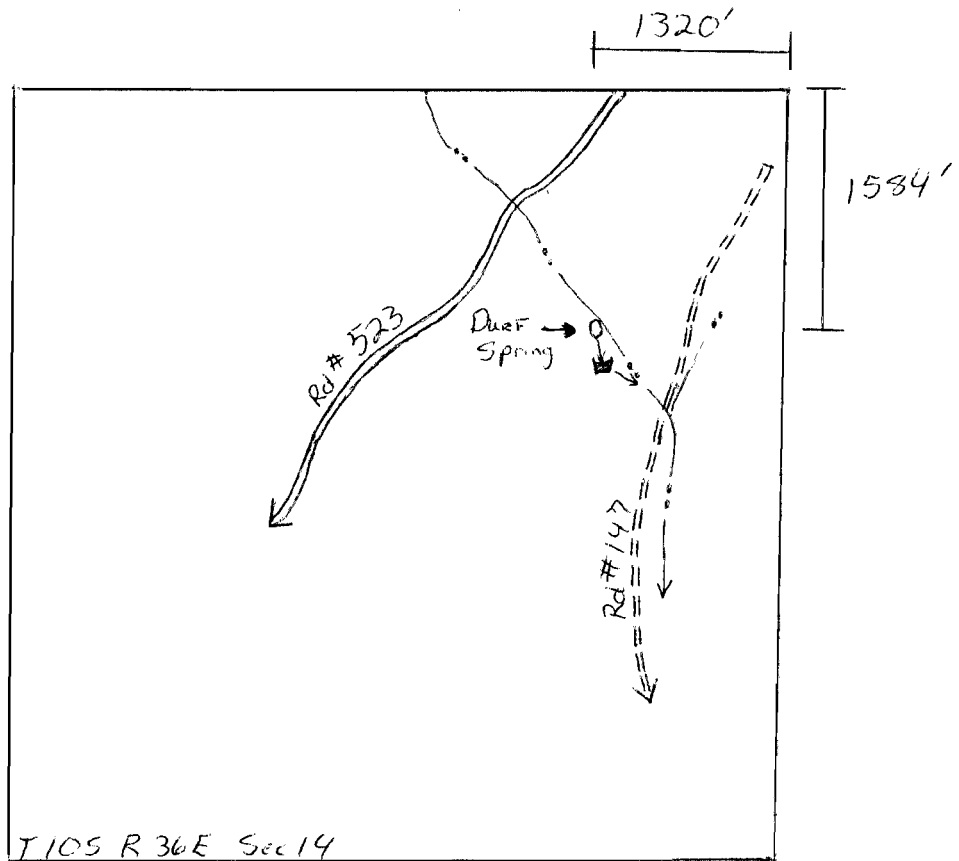

4" = 1 mile



RECEIVED
MAR 24 1983
WATER RESOURCES DEPT.
SALEM, OREGON

RECEIVED
SEP 7 1982
WATER RESOURCES DEPT.
SALEM, OREGON