


Application No. 64128
Permit No. 48824

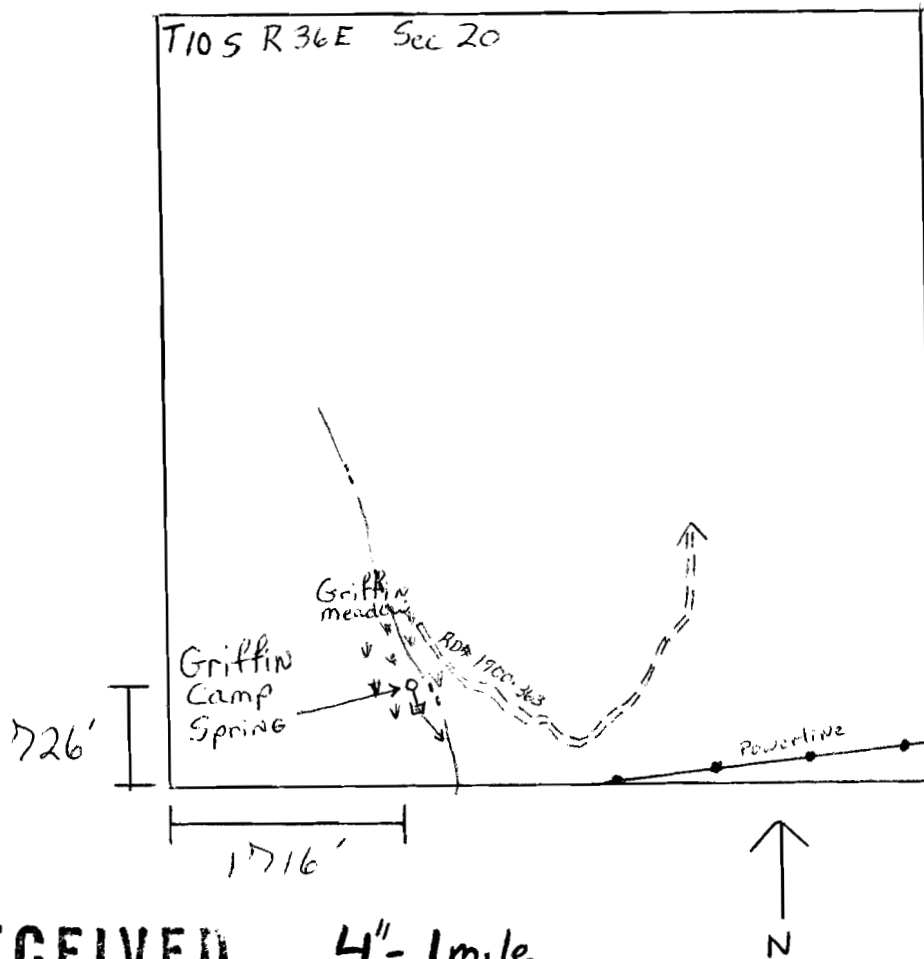

RECEIVED

SEP 7 1982

WATER RESOURCES DEPT.
SALEM, OREGON