


Application No. 64129
Permit No. 48825

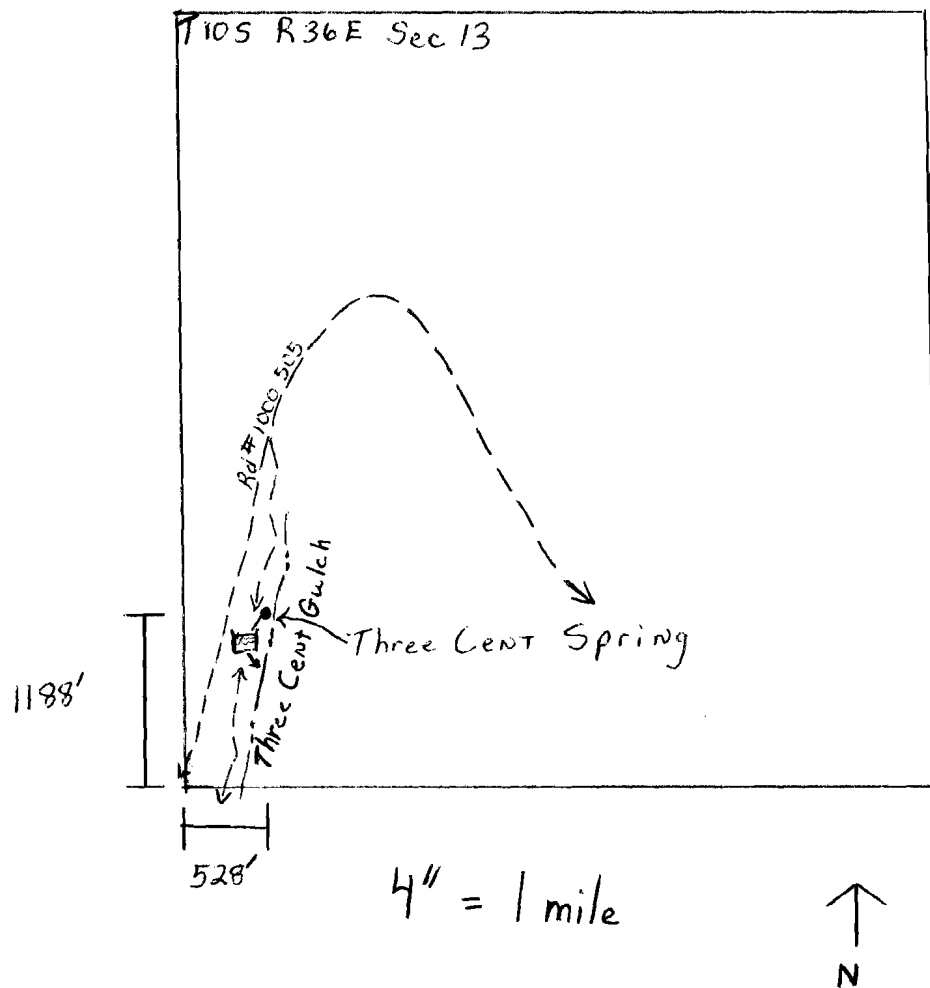

RECEIVED
SEP 7 1982
WATER RESOURCES DEPT.
SALEM, OREGON