



Application No. 64130
Permit No. 48826

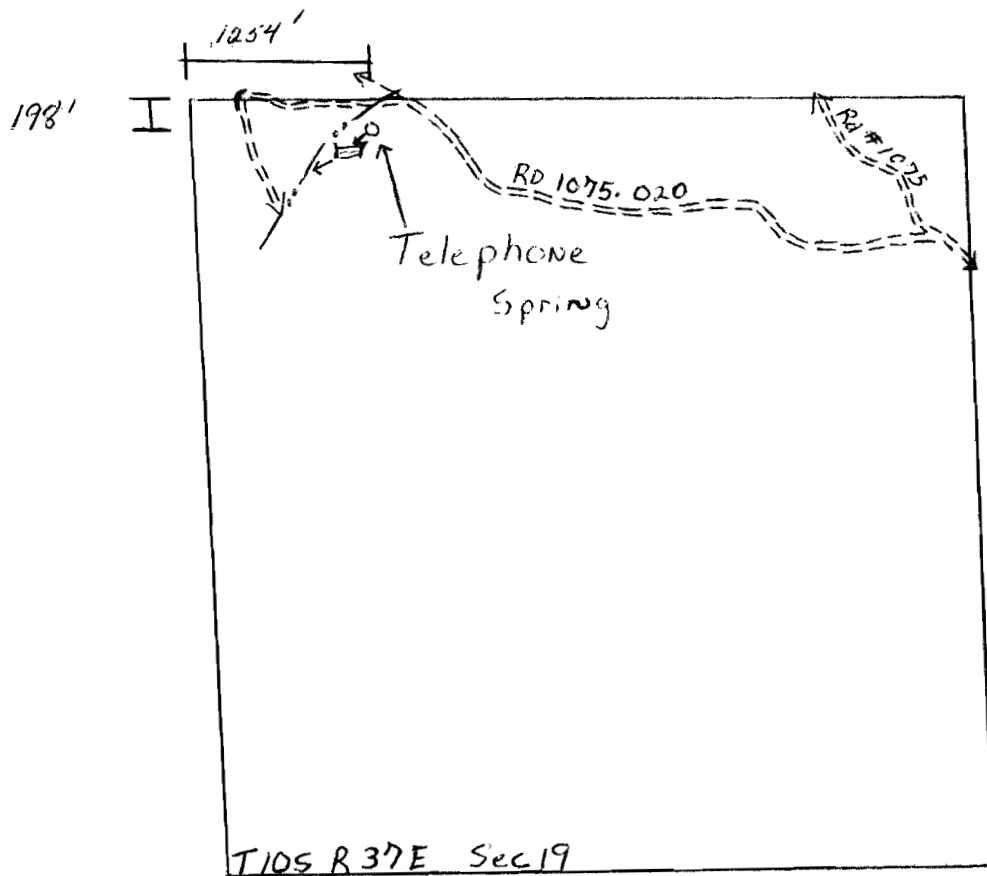

4" = 1 mile

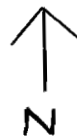

RECEIVED

SEP 7 1982

WATER RESOURCES DEPT.
SALEM, OREGON