


RECEIVED

SEP 8 1983
WATER RESOURCES DEPT.
SALEM, OREGON

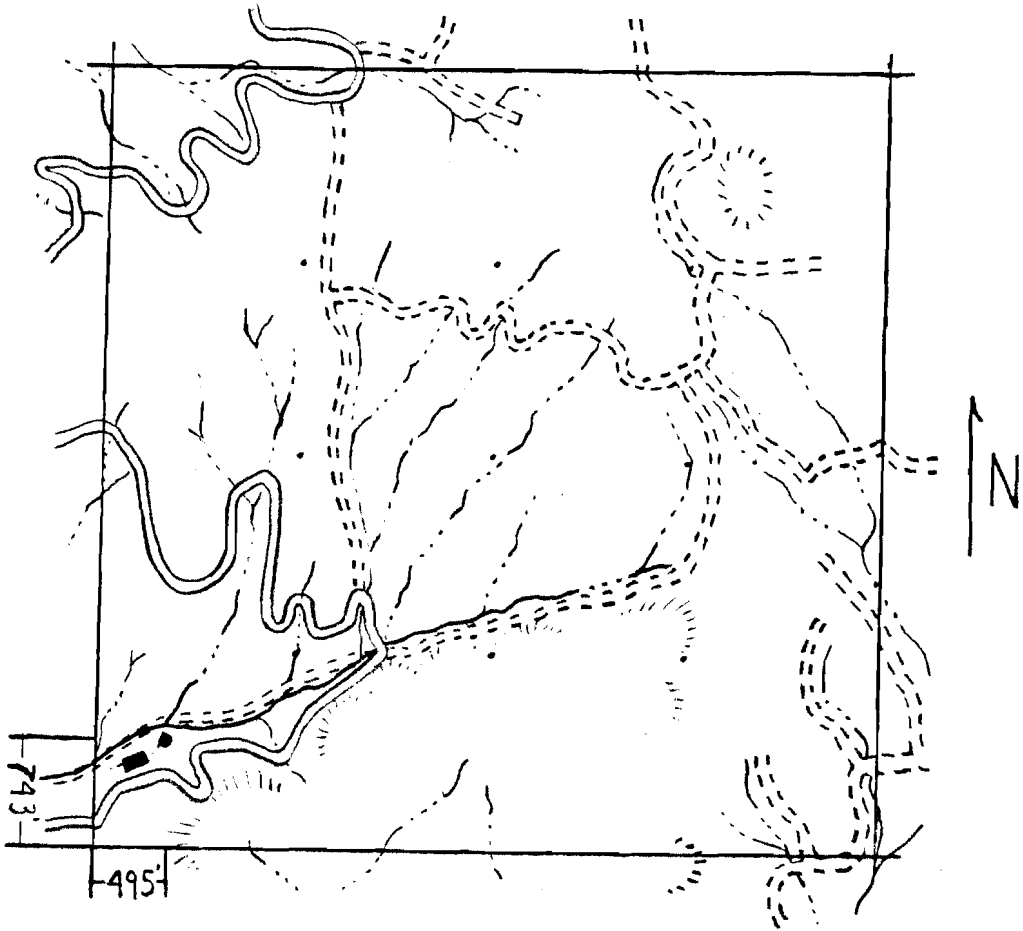

4 inches = 1 mile

T 7 S R 43 E Sec 25

Application No. 64092

Permit No. 48922