RECEIVED
SEP 8 1983
WATER RESOURCES DEPT.
SALEM, OREGON

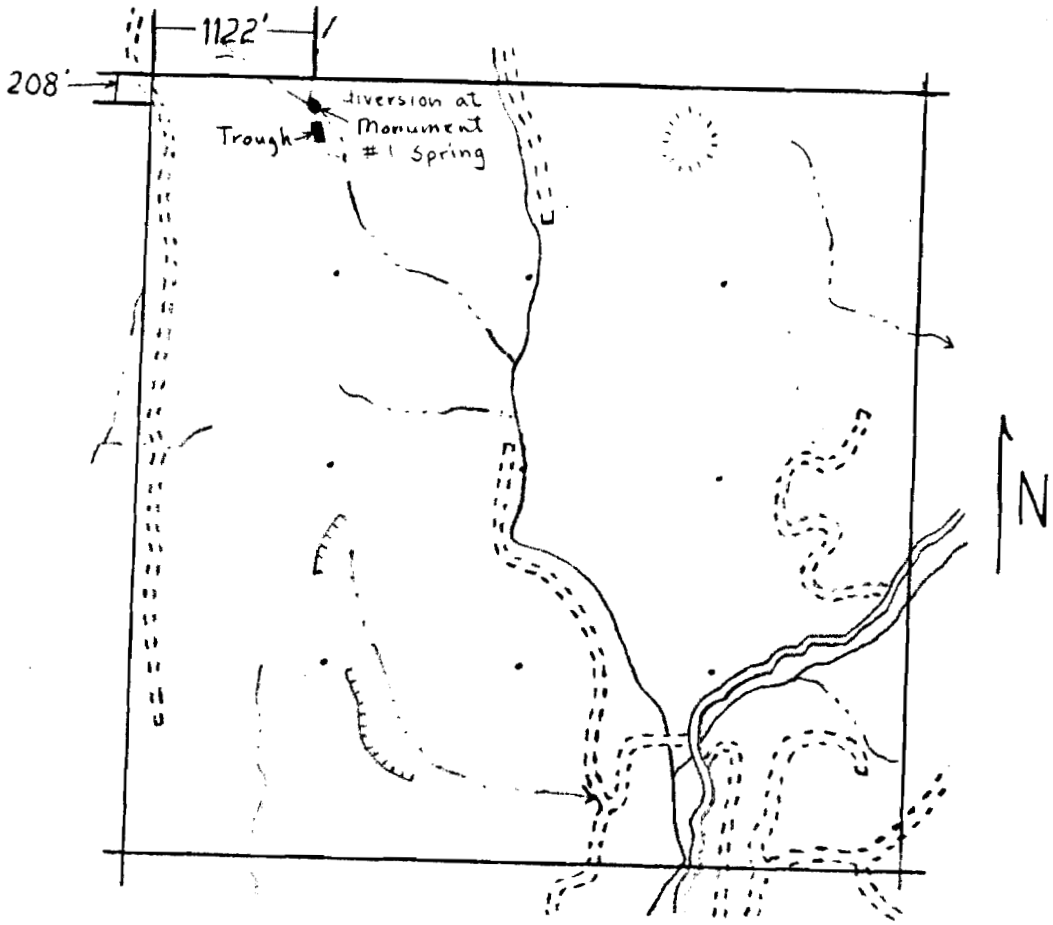

4 inches = 1 mile T 7 S R 43 E Sec 34

Application No. 64094
Permit No. 48924