

RECEIVED

AUG 12 1981

WATER RESOURCES DEPT
SALEM, OREGON


RIGGLES TRICKLE

Application No. 62218
Permit No. 49028

RECEIVED

MAR 4 1983

WATER RESOURCES DEPT.
SALEM, OREGON

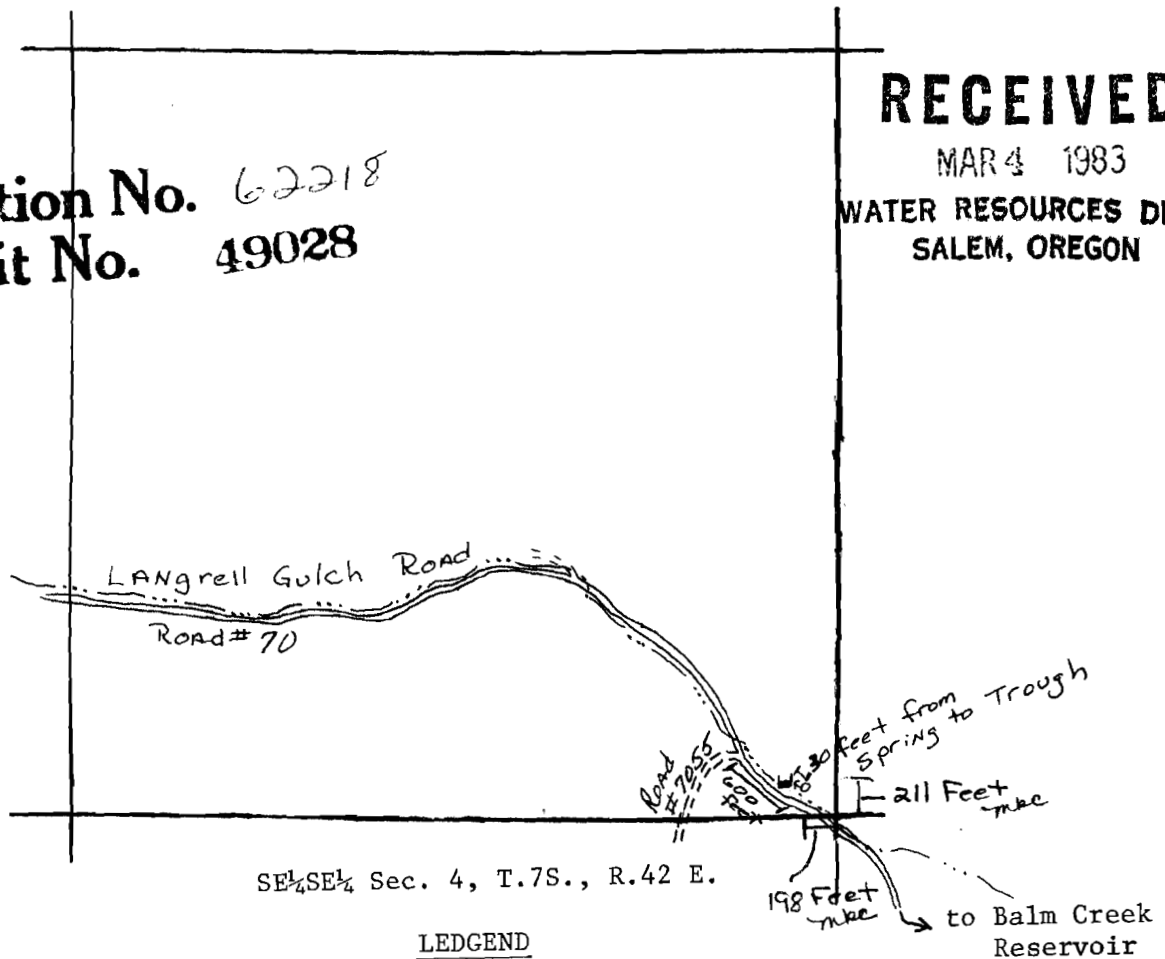

LEDGEND

Water Trough	
Spring Head	
Drainage	
Main Road	
Auxiliary Road	

Four Inches = One Mile

