

RECEIVED


AUG 12 1981

WATER RESOURCES DEPT
SALEM, OREGON

RECEIVED

MAR 4 1983

WATER RESOURCES DEPT.
SALEM, OREGON

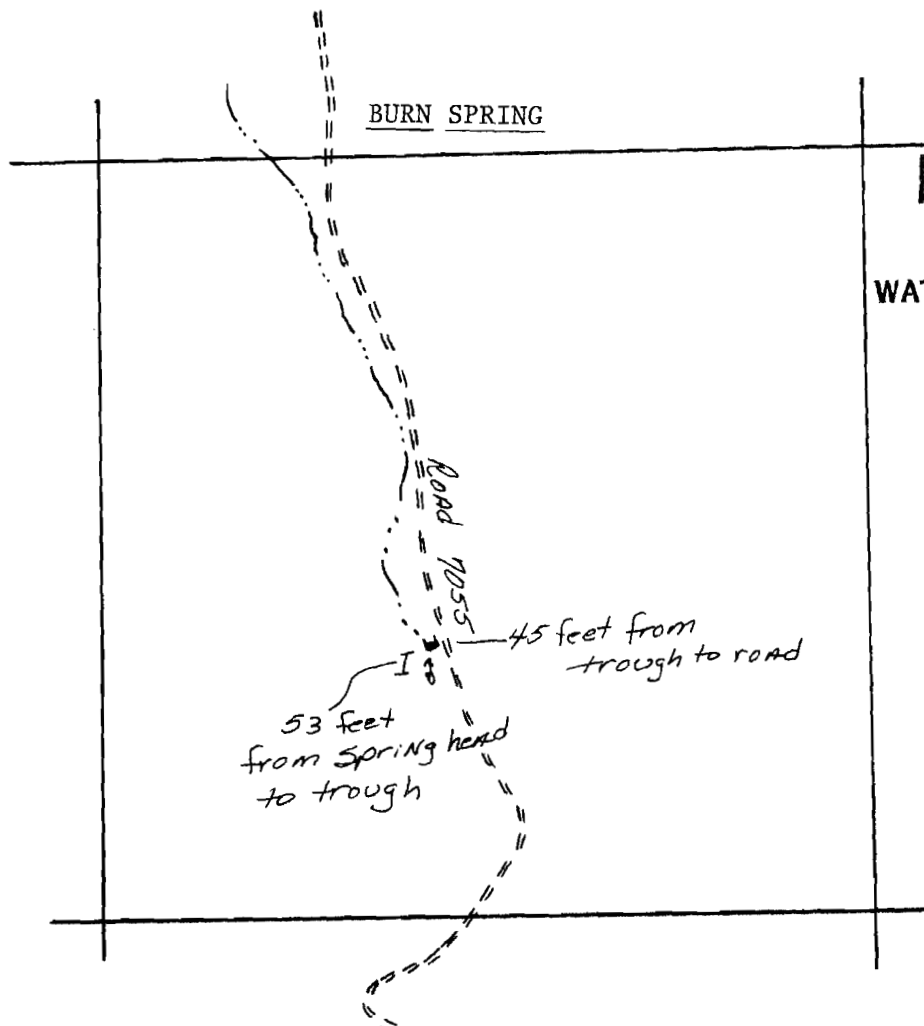


NE $\frac{1}{4}$ SW $\frac{1}{4}$ Sec. 2, T.7S., R.42E.


Burn Spring Located: 1650 feet North and 2227 feet East from the
Water Trough  SW corner section 2

Spring Head 

Drainage 

 Road 

Four Inches = One Mile

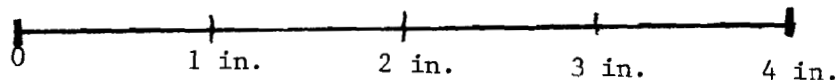

Application No. 6222/
Permit No. 49030