


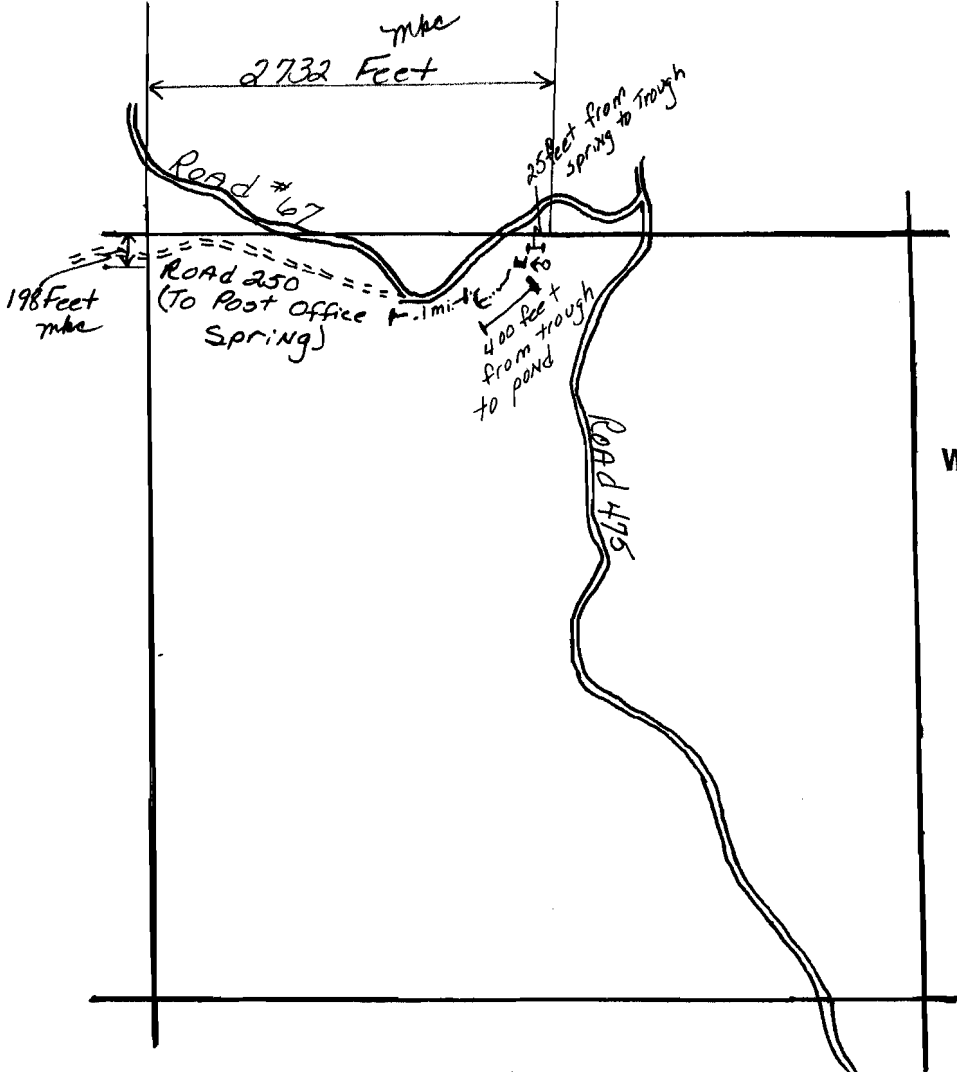

RECEIVED

AUG 12 1981

WATER RESOURCES DEPT
SALEM, OREGON

RECEIVED

MAR 4 1983

WATER RESOURCES DEPT.
SALEM, OREGON

WATERTOWER


NW NE
NE 1/4 Sec. 36, T.6S.,
mke R.42E.

TO BALM Creek
Reservoir

LEDGEND

- Water Trough 
- Spring Head 
- Main Road 
- Auxillary Road 

Four Inches = One Mile

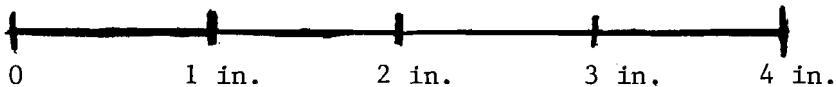

Application No. 62222
Permit No. 49031