


RECEIVED

AUG 12 1981

WATER RESOURCES DEPT
SALEM, OREGON

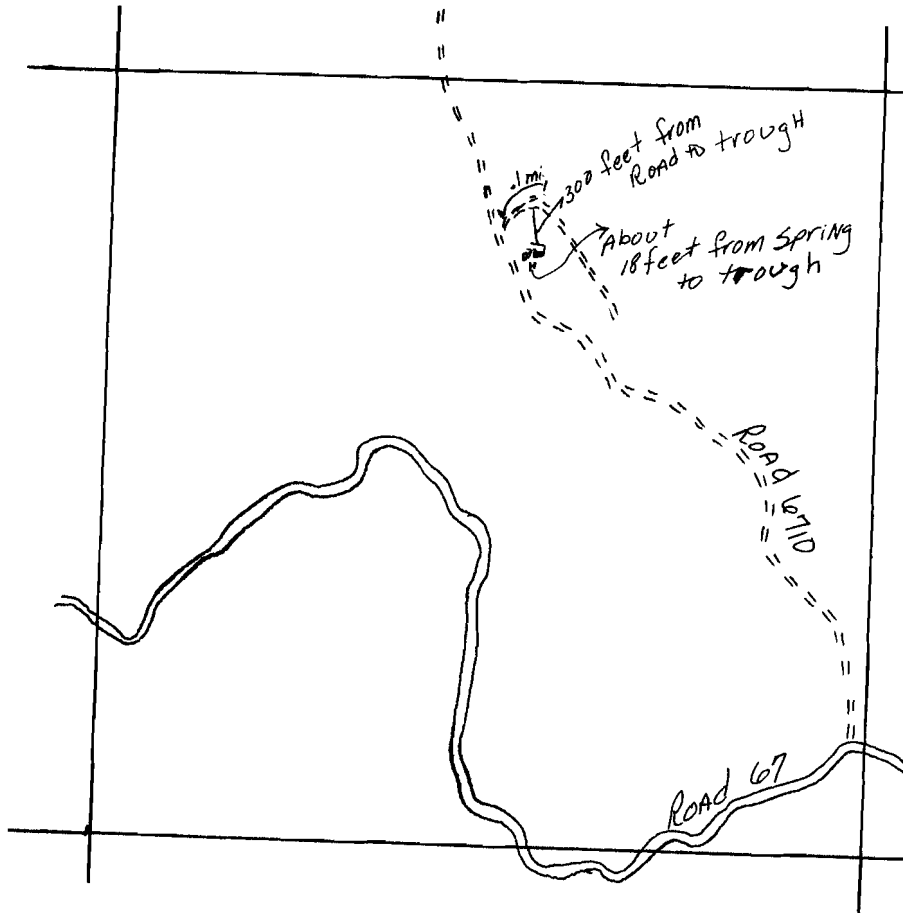

STEIGER SPRING


NW $\frac{1}{4}$ NE $\frac{1}{4}$ Sec. 30, T.6S., R.43E.

Steiger Spring Located: 1155 ft. S. and 2475 ft. W. from the NE corner Section 30

Water Trough 

Spring Head 

Main Road 

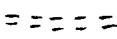Auxiliary Road 

Application No. 62223
Permit No. 49032

Four Inches = One Mile

