

RECEIVED


AUG 12 1981


WATER RESOURCES DEPT
SALEM, OREGON

RECEIVED

MAR 4 1983

WATER RESOURCES DEPT.
SALEM, OREGON

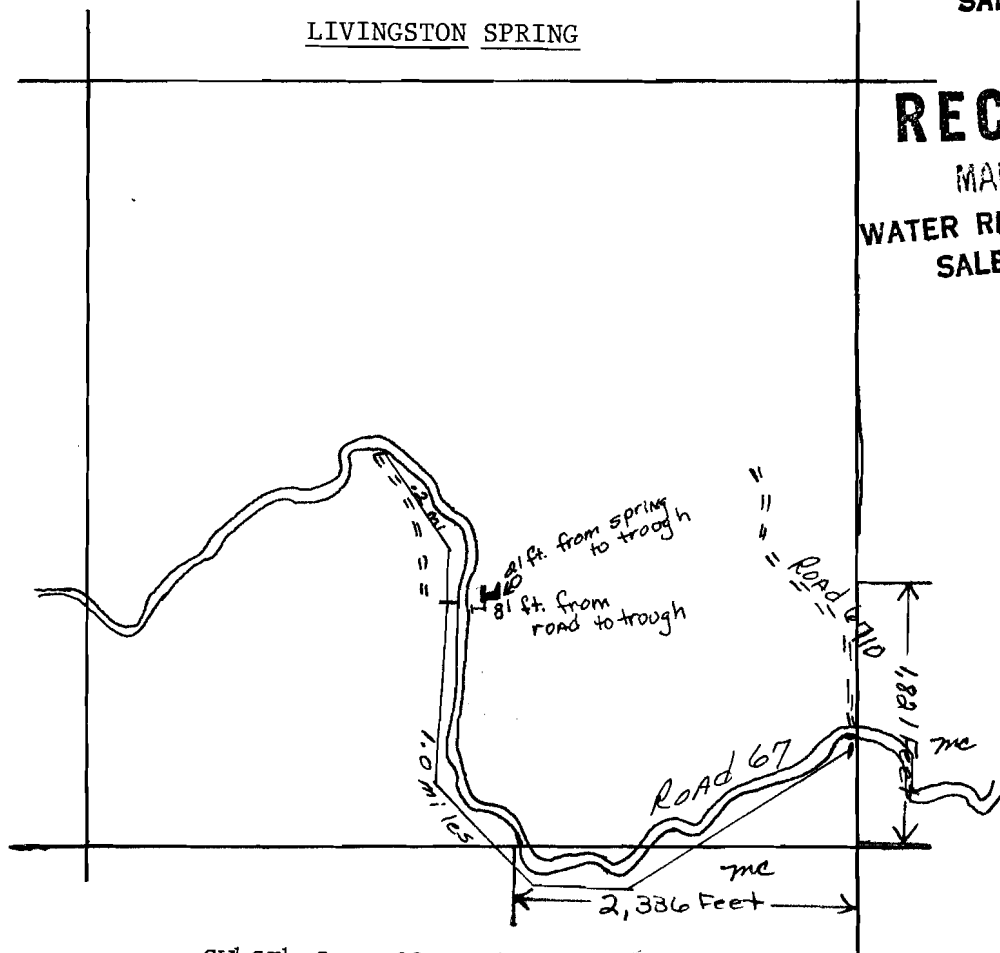

 - Water Trough 
- Spring Head 
- Main Road 
- Auxiliary Road 

Application No. 62224
Permit No. 49033

Four Inches = One Mile

