


RECEIVED

AUG 12 1981

WATER RESOURCES DEPT

SALEM, OREGON

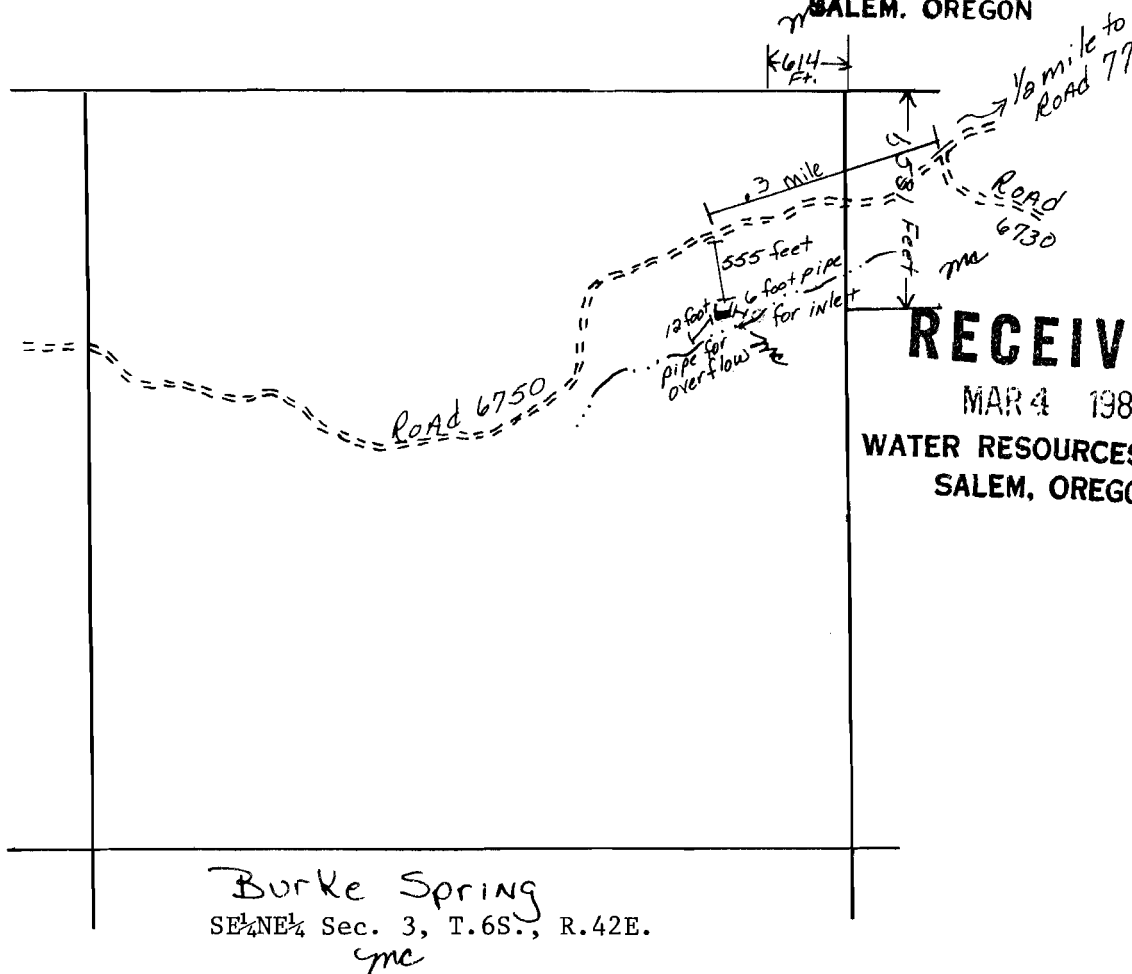

RECEIVED

MAR 4 1983

WATER RESOURCES DEPT.
SALEM, OREGON


Water Trough



Drainage



Road

 

Application No. 62225
Permit No. 49034

Four Inches = One Mile

