

COLD SPRING and STOCK POND

RECEIVED


AUG 12 1981

WATER RESOURCES DEPT
SALEM, OREGON

RECEIVED

MAR 4 1983

WATER RESOURCES DEPT.
SALEM, OREGON

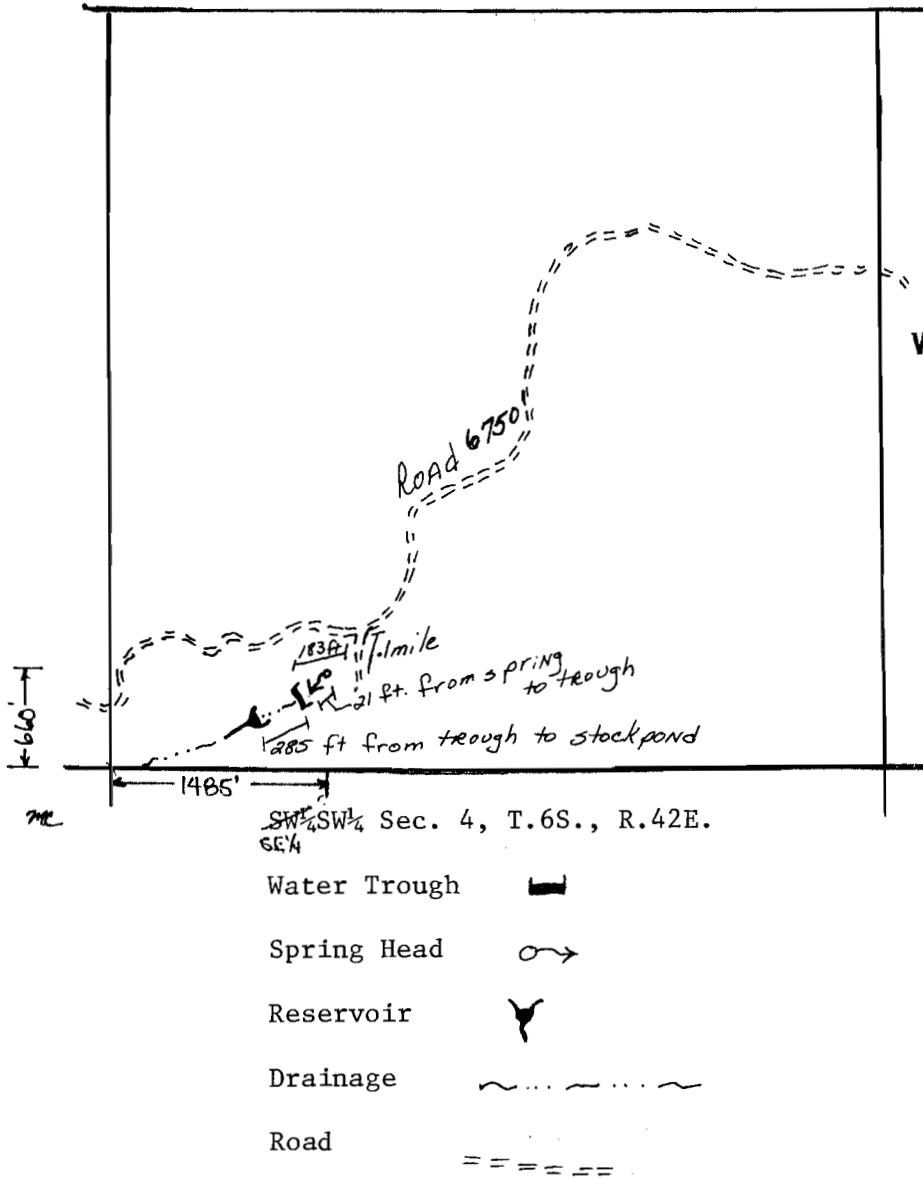

Application No. 62227
Permit No. 49035