


RECEIVED


AUG 12 1981

WATER RESOURCES DEPT
SALEM, OREGON

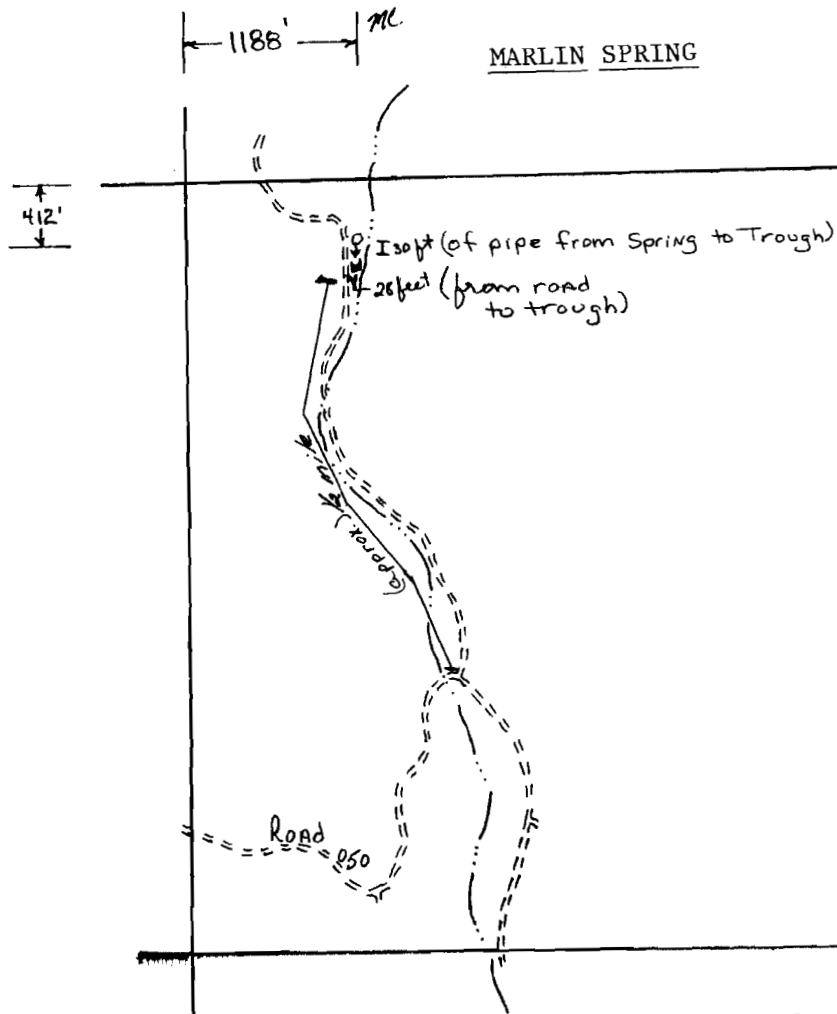


NW $\frac{1}{4}$ NW $\frac{1}{4}$ Sec. 17, T.6S., R.42E.

LEDGEND

 Trough	
Spring	
Drainage	
Road	

Four Inches = One Mile

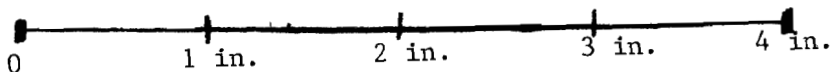

RECEIVED

MAR 4 1983

WATER RESOURCES DEPT.
SALEM, OREGON

Application No. 62229
Permit No. 49036