RECEIVED
AUG 12 1981
WATER RESOURCES DEPT
SALEM, OREGON

RECEIVED
MAR 4 1983
WATER RESOURCES DEPT.
SALEM, OREGON

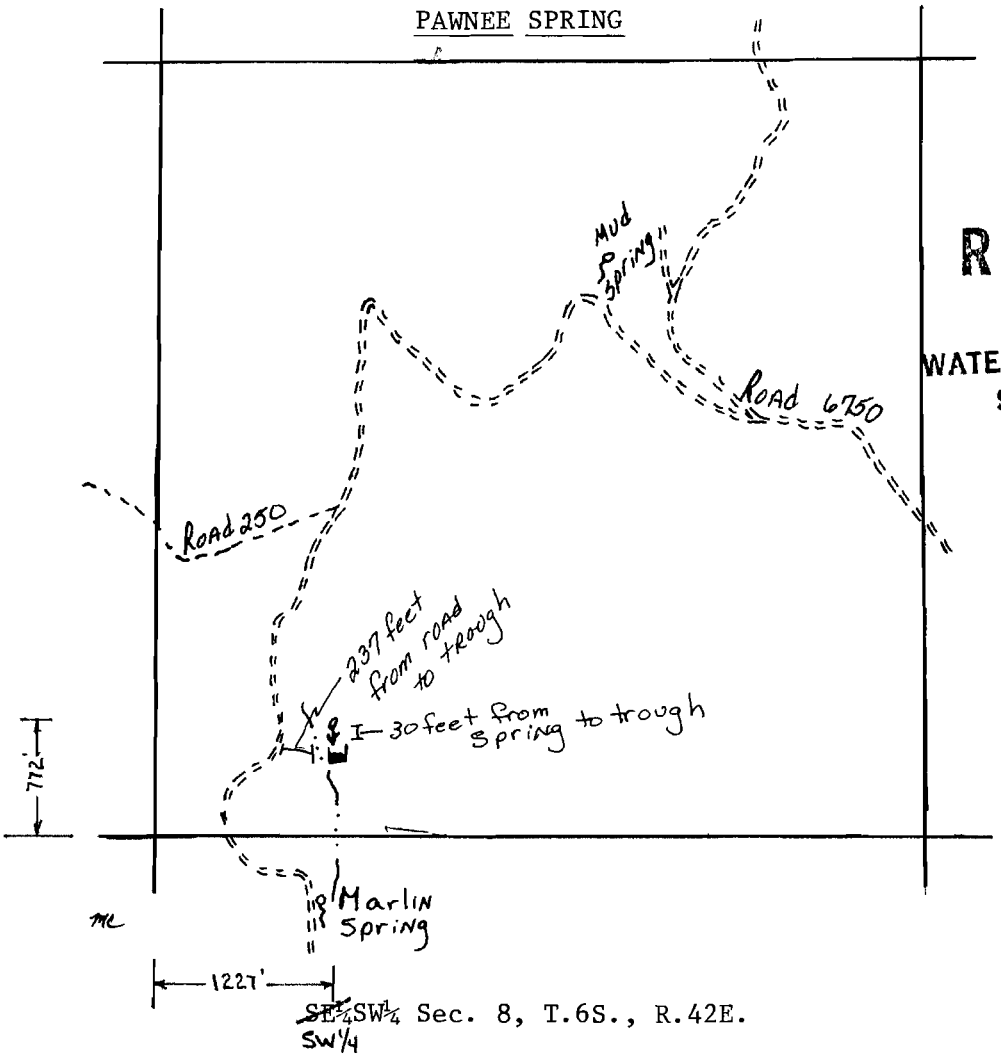

SE¼SW¼ SW¼ Sec. 8, T.6S., R.42E.

Water Trough

Spring Head

Drainage

Road

Trail

Four Inches = One Mile

0 1 in. 2 in. 3 in. 4 in.

Application No. 67230
Permit No. 49037