


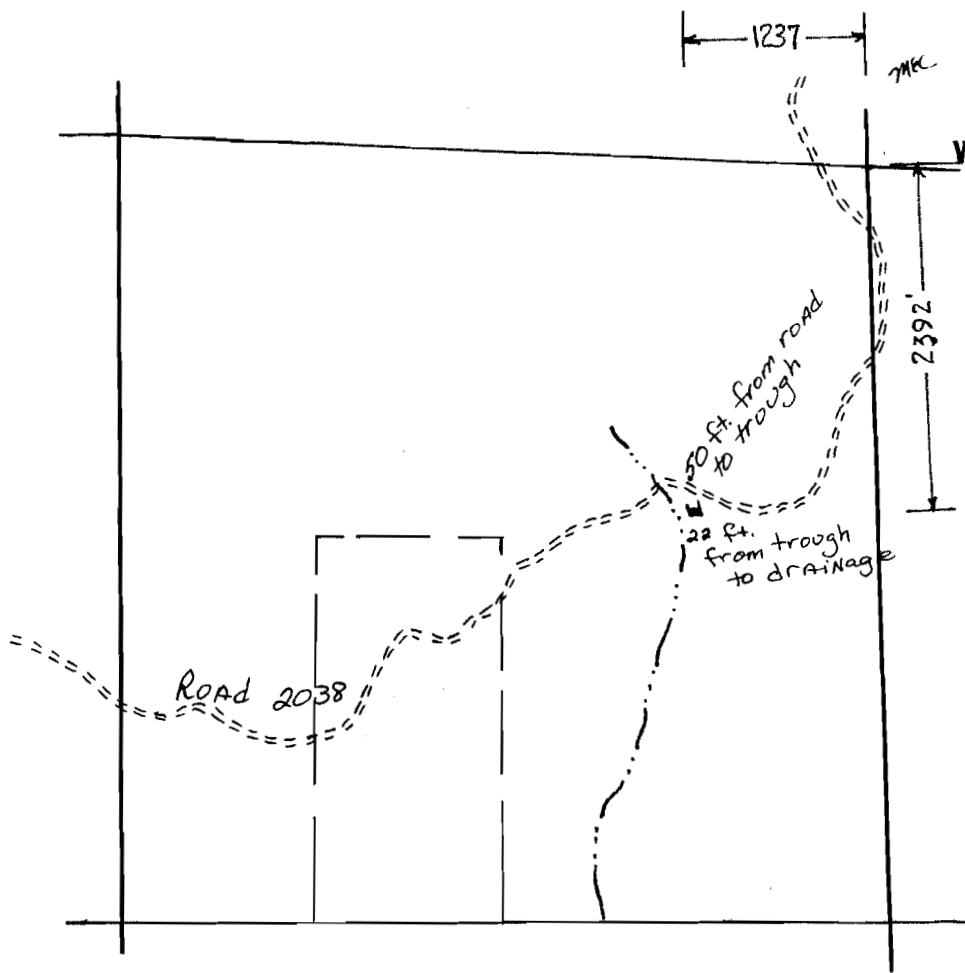

RECEIVED

AUG 12 1981

WATER RESOURCES DEPT
SALEM, OREGON



RECEIVED


MAR 4 1983

WATER RESOURCES DEPT.
SALEM, OREGON

MERRY SPRING

SW $\frac{1}{4}$ NE $\frac{1}{4}$ Sec. 14, T.5S., R.41E.

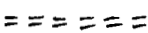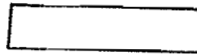Water Trough	
Drainage	
Road	
Private Land	

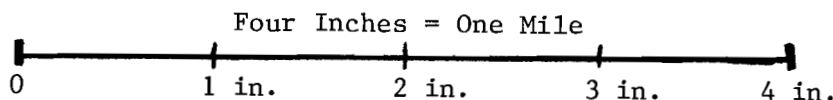

Application No. 62233
Permit No. 49039