


RECEIVED

AUG 12 1981

WATER RESOURCES DEPT
SALEM, OREGON

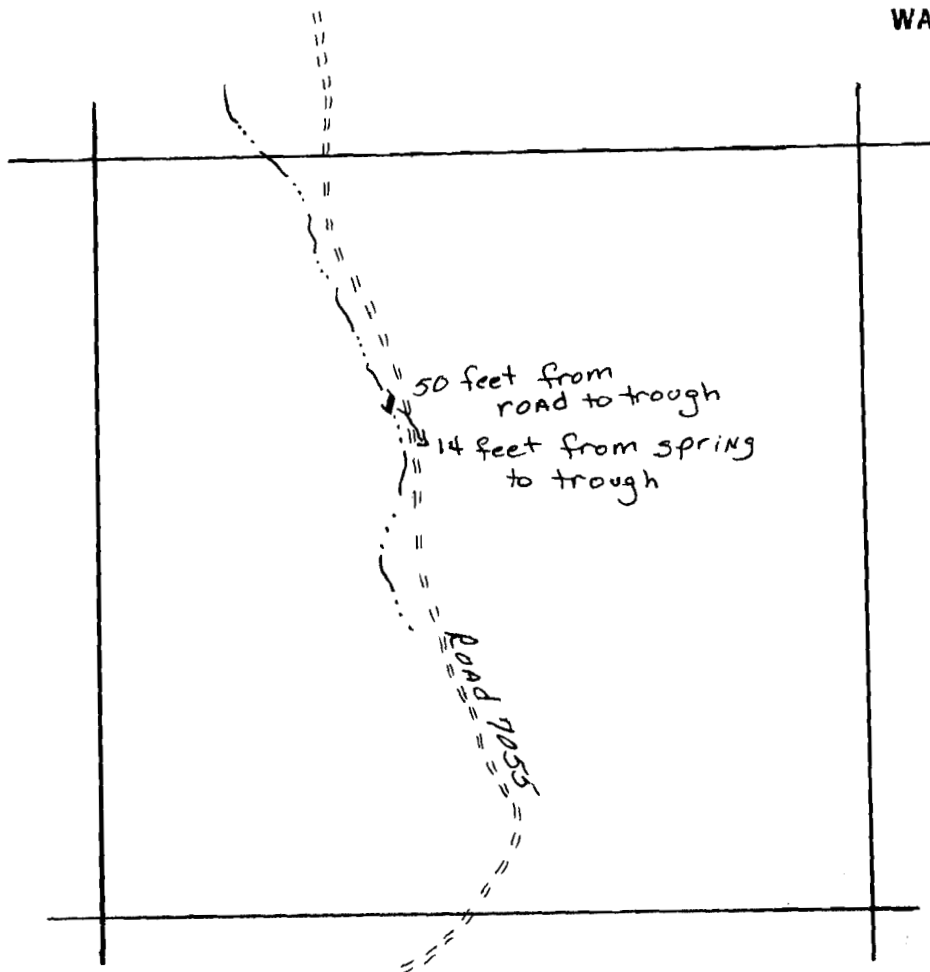


POST OFFICE SPRING


SE $\frac{1}{4}$ NW $\frac{1}{4}$ Sec. 2, T.7S., R.42E.

Spring located: 1650 ft. S. and 1980 ft. W. from the NW corner Section 2
Water Trough 

Drainage 

 Road 

Four Inches = One Mile

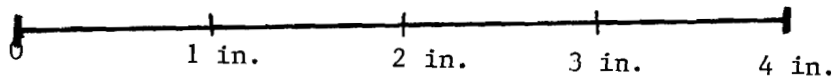

Application No. 62234

Permit No.

49040