


RECEIVED

AUG 12 1981


WATER RESOURCES DEPT
SALEM, OREGON

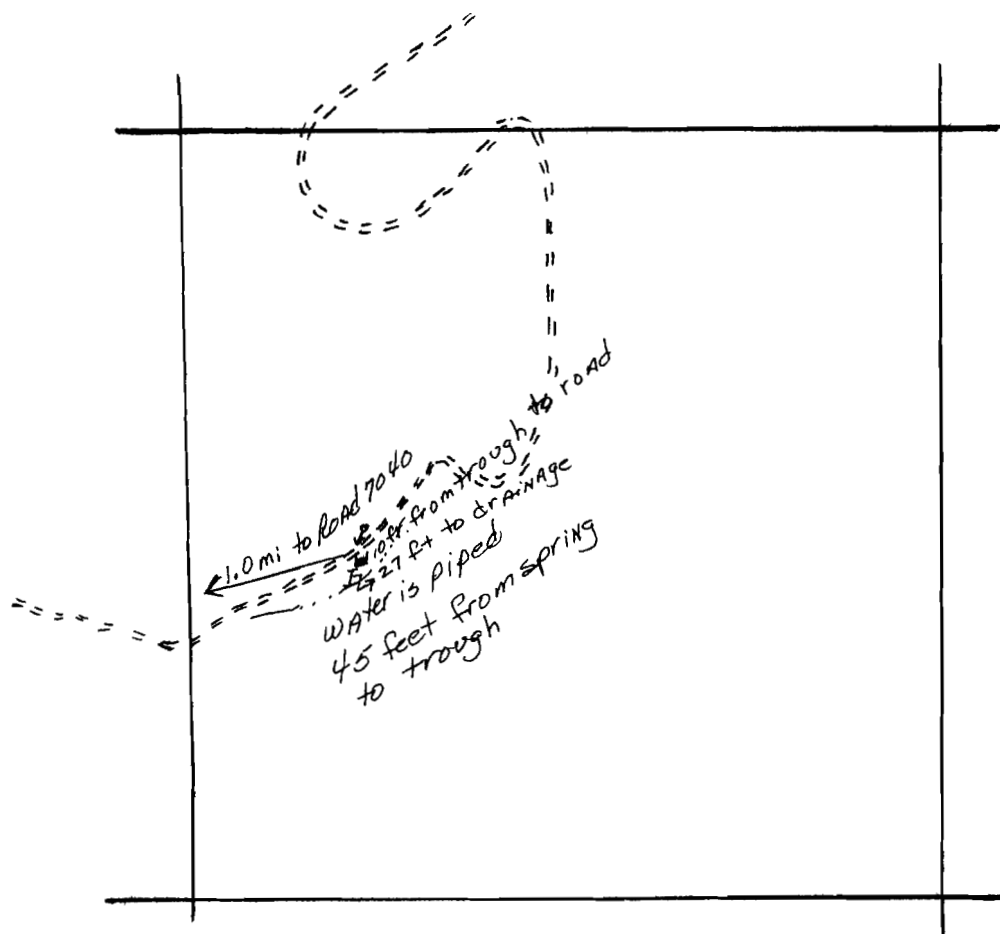

NW $\frac{1}{4}$ SW $\frac{1}{4}$ Sec. 21, T.7S., R.43E.


Spring Located: 2557 ft. N. and 1237 ft. E. from the SW corner Section 21
Water Trough 

Spring Head 

 Road 

Drainage 

Four Inches = One Mile

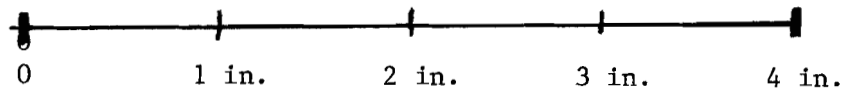

Application No. 62235
Permit No. 49041