

16
RECEIVED

AUG 12 1981

WATER RESOURCES DEPT
SALEM, OREGON


Application No. 62236
Permit No. 49042

RECEIVED

MAR 4 1983

WATER RESOURCES DEPT.
SALEM, OREGON

BLACK PINE SPRING

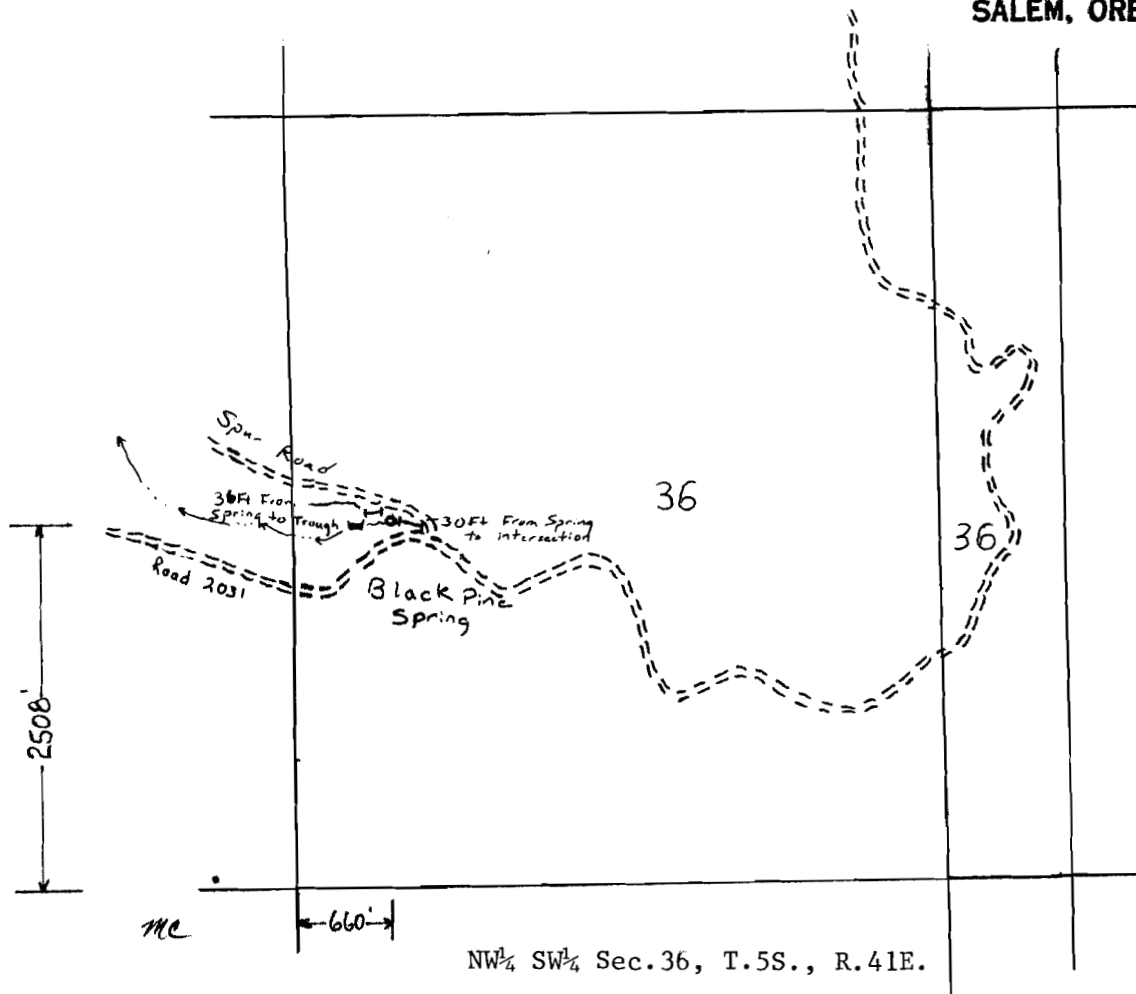


Water Trough



Spring Head



Drainage

 

Main Road



Four Inches = One Mile

