


RECEIVED

AUG 12 1981

WATER RESOURCES DEPT
SALEM, OREGON

Application No. 62238
Permit No. 49044

FAULKNER SPRING

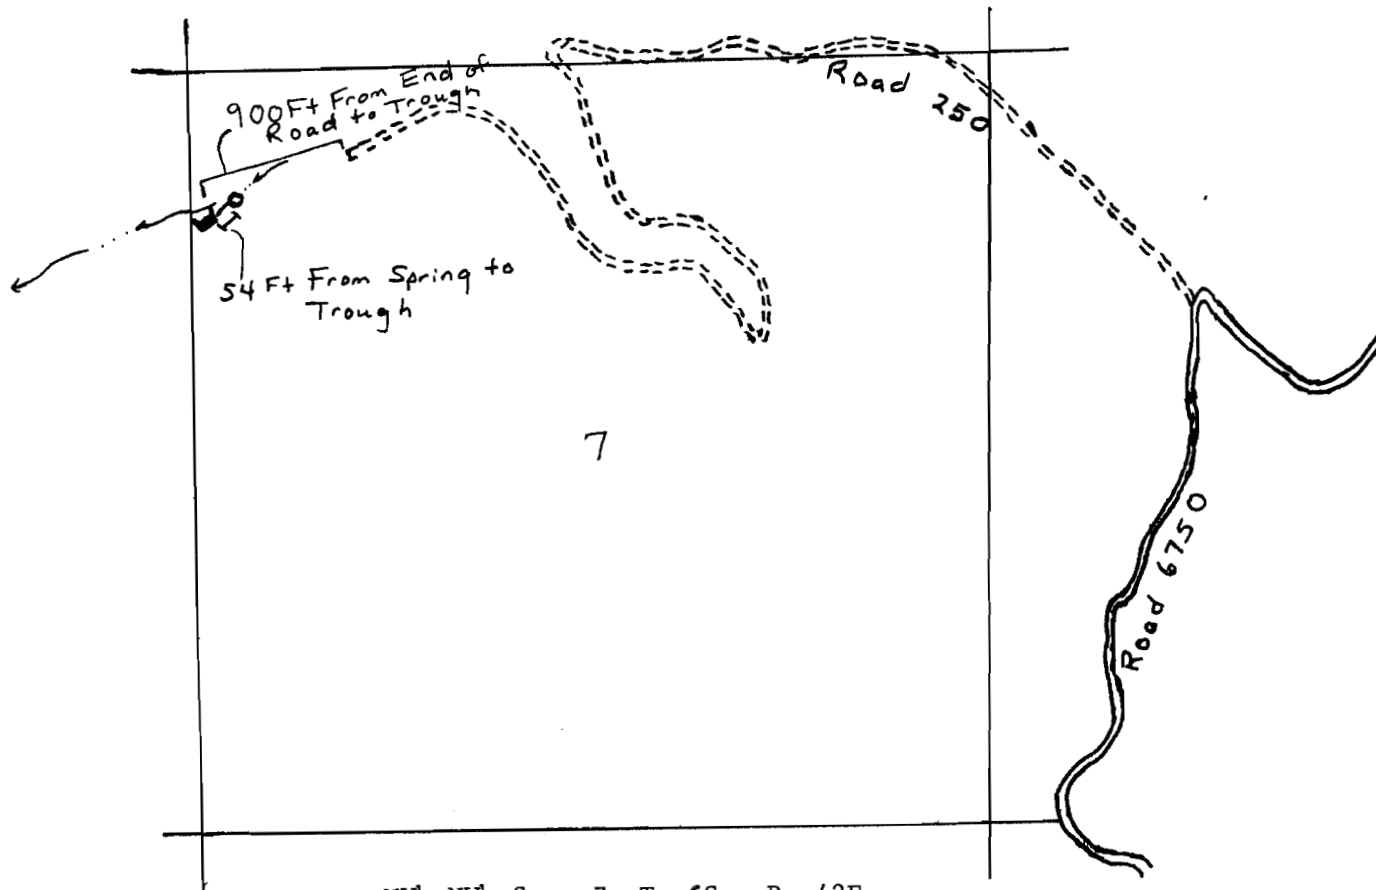

NW $\frac{1}{4}$ NW $\frac{1}{4}$ Sec. 7, T. 6S., R. 42E.

Faulkner Spring Located: 990 ft. S. and 165 ft. E. form the NW corner Section 7

Water Trough - - - - -
Spring Head - - - - -
Drainage - - - - -
Main Road - - - - -
Spur Road - - - - -

Four Inches = One Mile

0 1 in. 2 in. 3 in. 4 in.