


Application No. 64202
Permit No. 49046

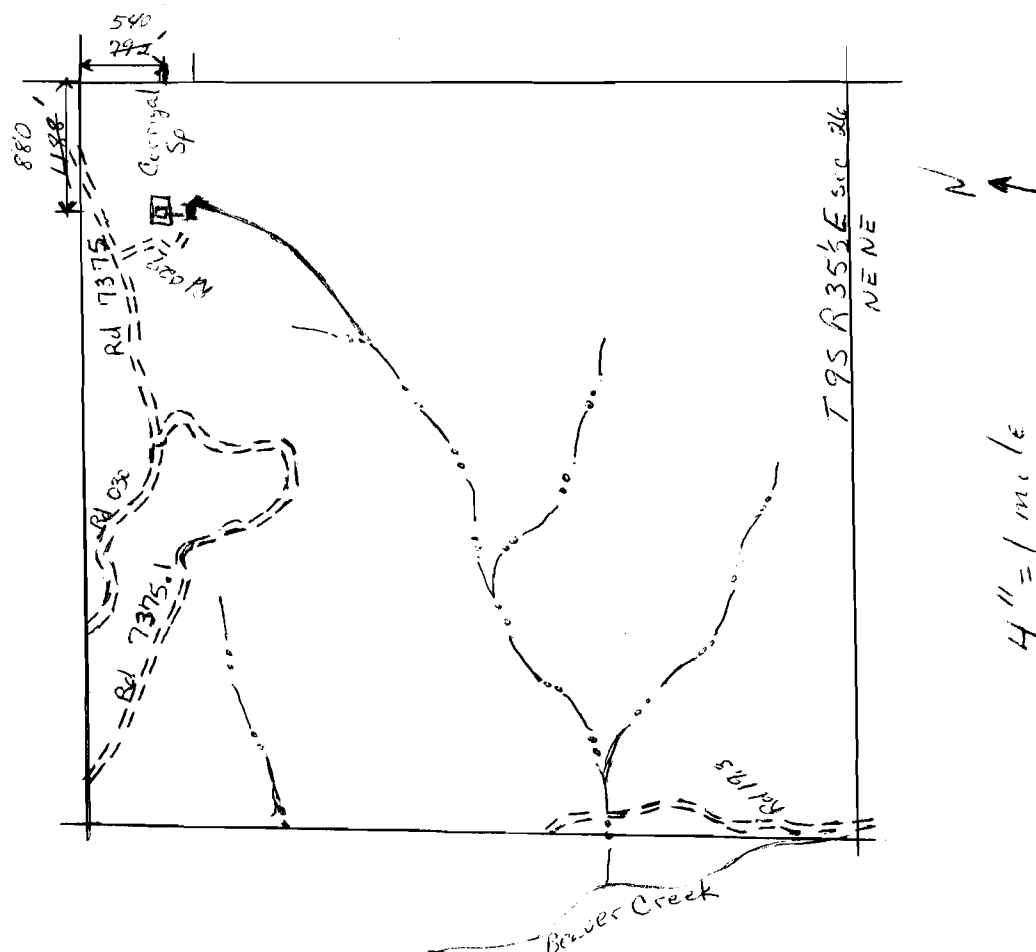

RECEIVED

JUN 24 1983

**WATER RESOURCES DEPT.
SALEM, OREGON**

RECEIVED

SEP 29 1982

WATER RESOURCES DEPT.
SALEM, OREGON