


Application No. 64203  
Permit No. 49047

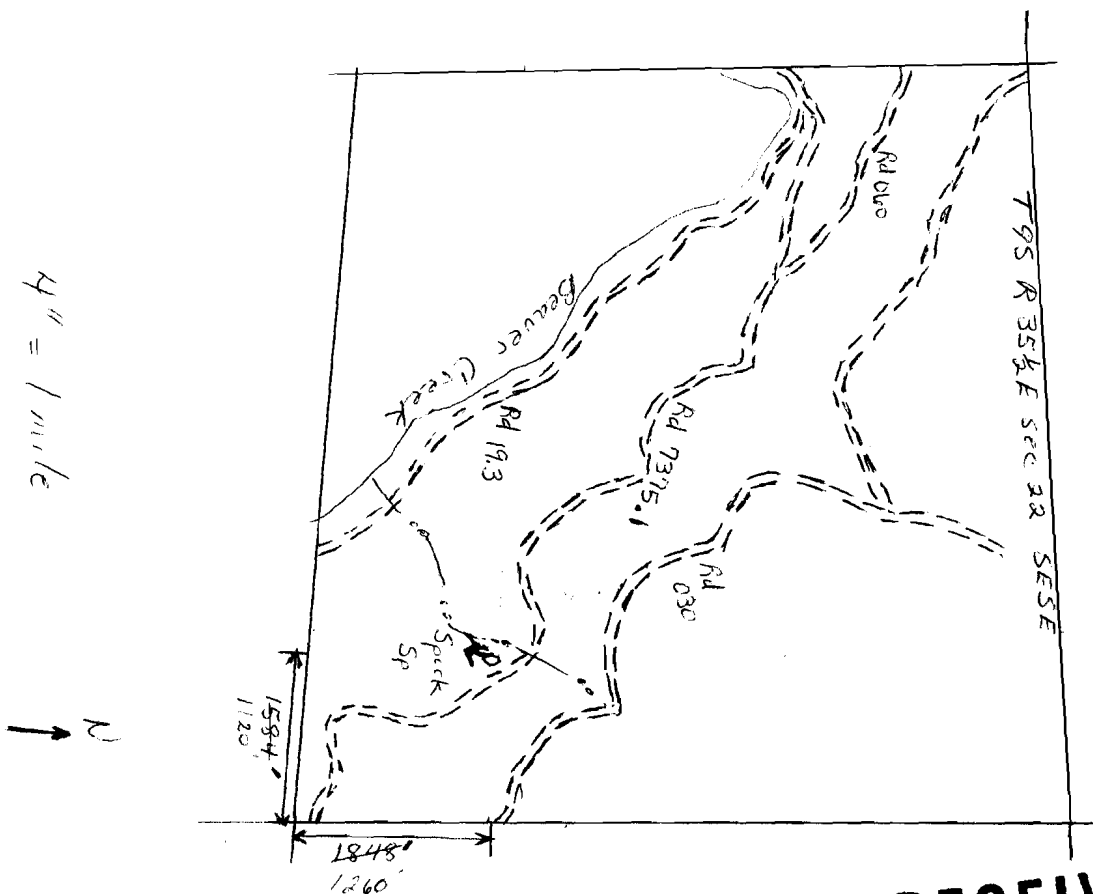

RECEIVED

JUN 24 1983

WATER RESOURCES DEPT. WATER RESOURCES DEPT.  
SALEM, OREGON

RECEIVED

SEP 29 1982

WATER RESOURCES DEPT.  
SALEM, OREGON