


Application No. 64204
Permit No. 49018

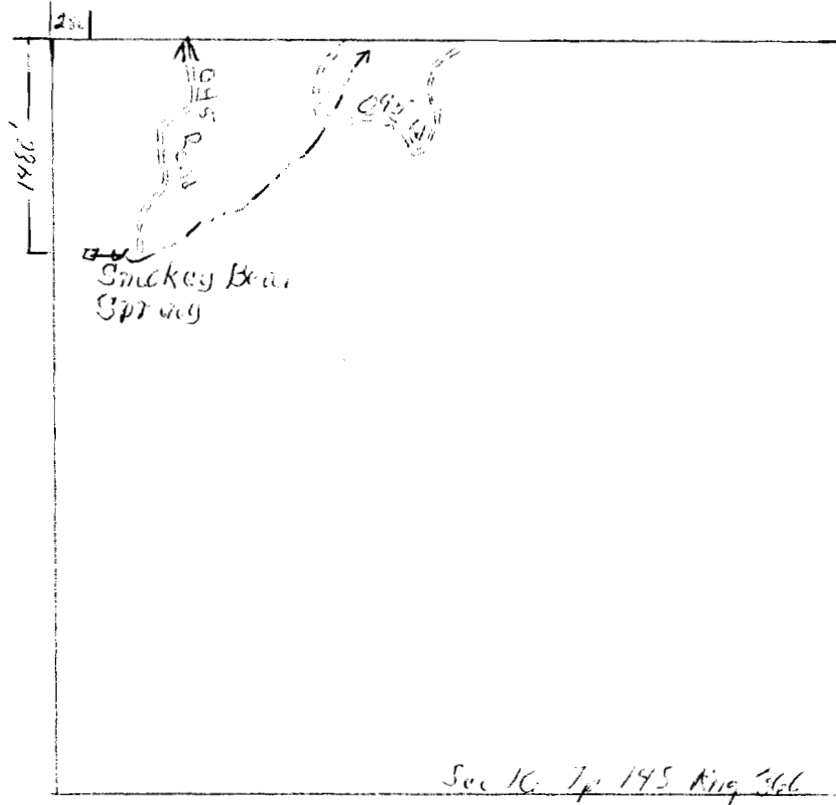

RECEIVED

SEP 29 1982

WATER RESOURCES DEPT.
SALEM, OREGON