


Application No. 64206
Permit No. 49050

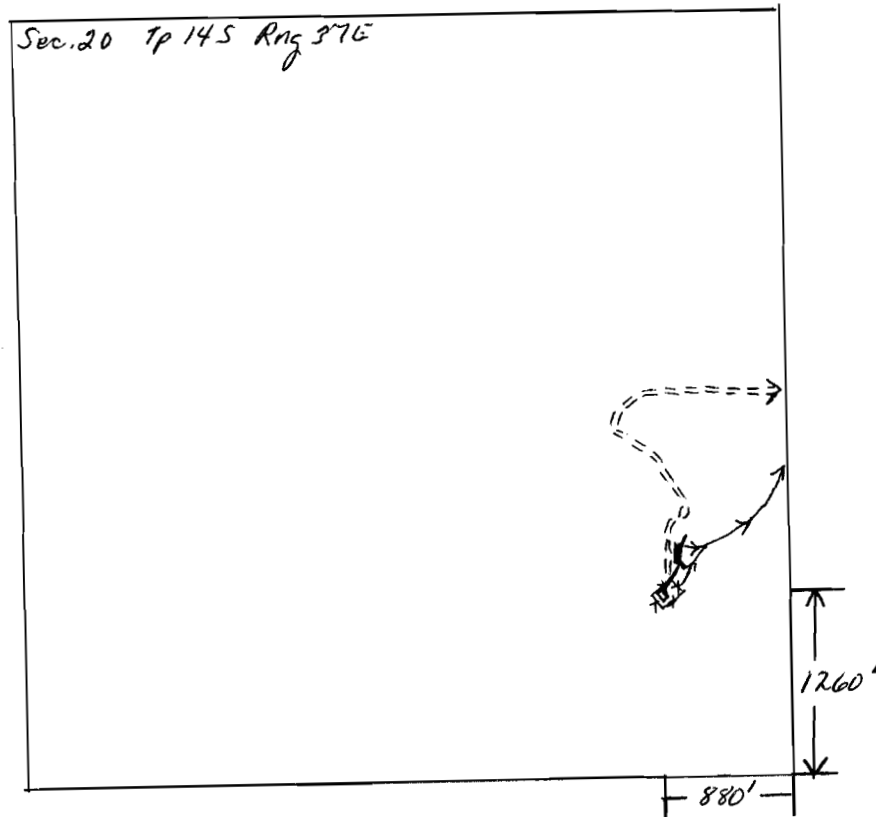

4" = 1 mile



RECEIVED
SEP 29 1982
WATER RESOURCES DEPT.
SALEM, OREGON