


7111

10532

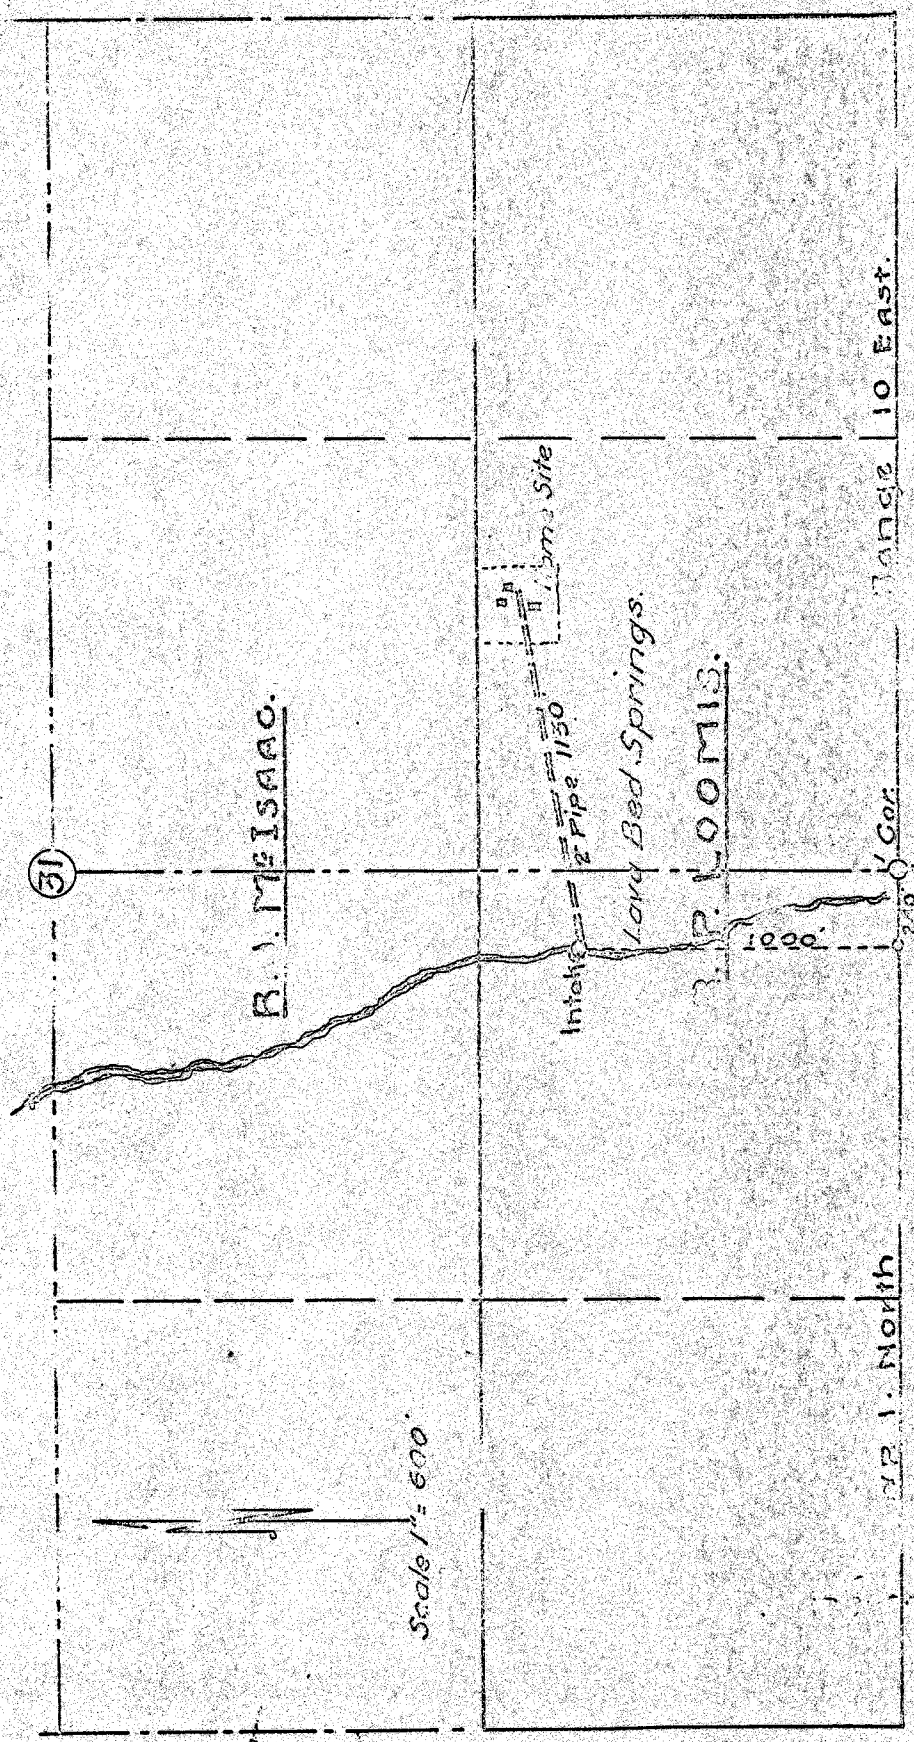

B. I. MEISAAC.

Intake = $\frac{1}{2}$ Pipe 1150

Lony Bed Springs.

B. P. LOOMIS.

Range 10 East.

Twp. 1. North

Scale 1" = 600'

C. M. Hubbs

10532

7111