


Application No. 64210
 Permit No.

49054

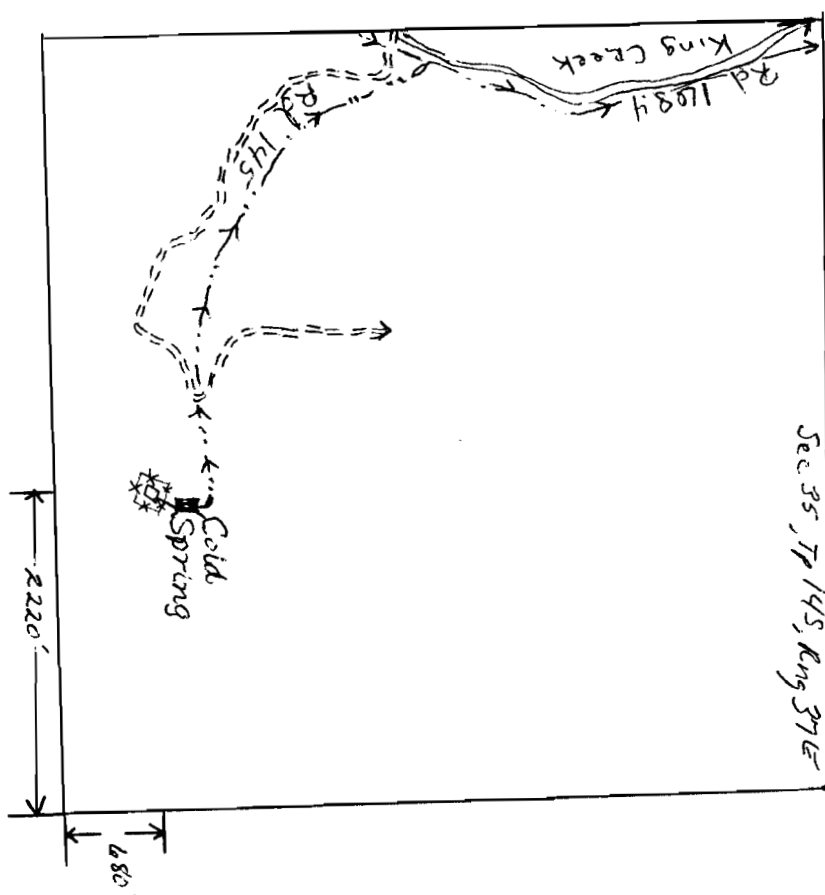

RECEIVED

SEP 29 1982

WATER RESOURCES DEPT.
 SALEM, OREGON