


Application No. 64212
Permit No. 49056

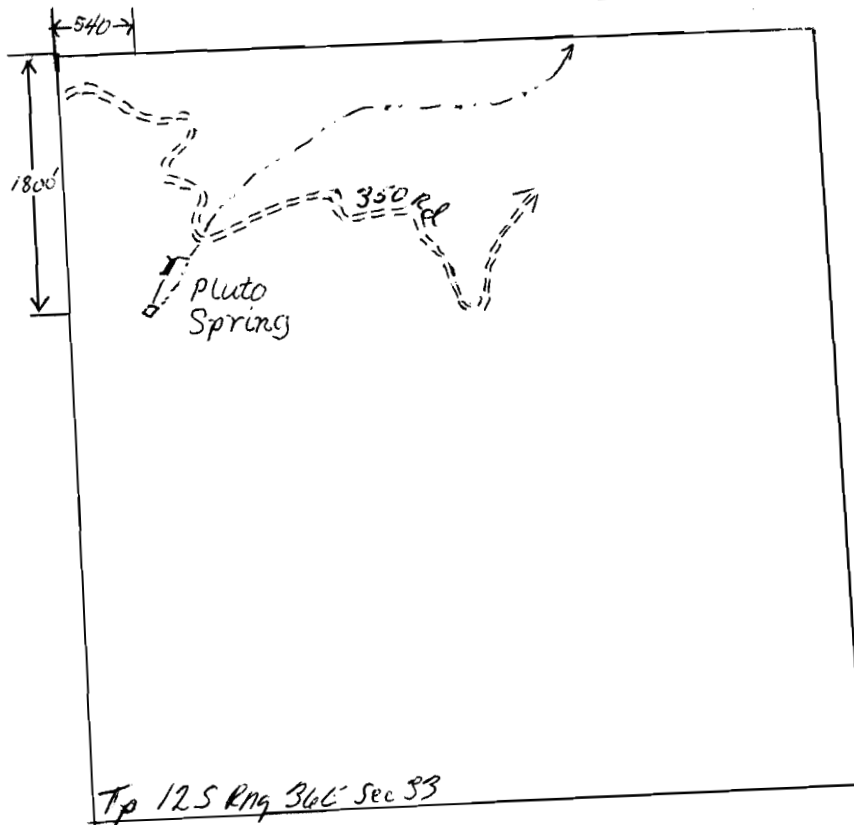

4" = 1 mile



RECEIVED

SEP 29 1982

WATER RESOURCES DEPT.
SALEM, OREGON