


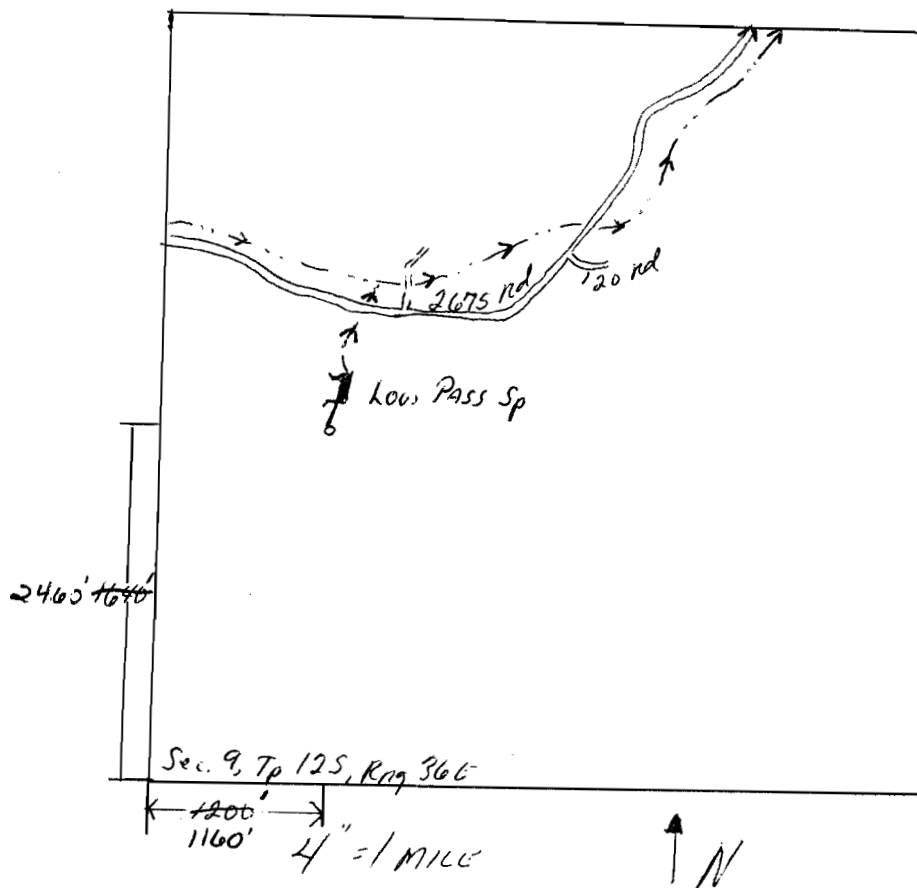

Application No. 64213  
Permit No. 49057

**RECEIVED**  
JUN 24 1983  
WATER RESOURCES DEPT.  
SALEM, OREGON

**RECEIVED**  
SEP 29 1982  
WATER RESOURCES DEPT.  
SALEM, OREGON