


Application No. 64214
Permit No. 49058

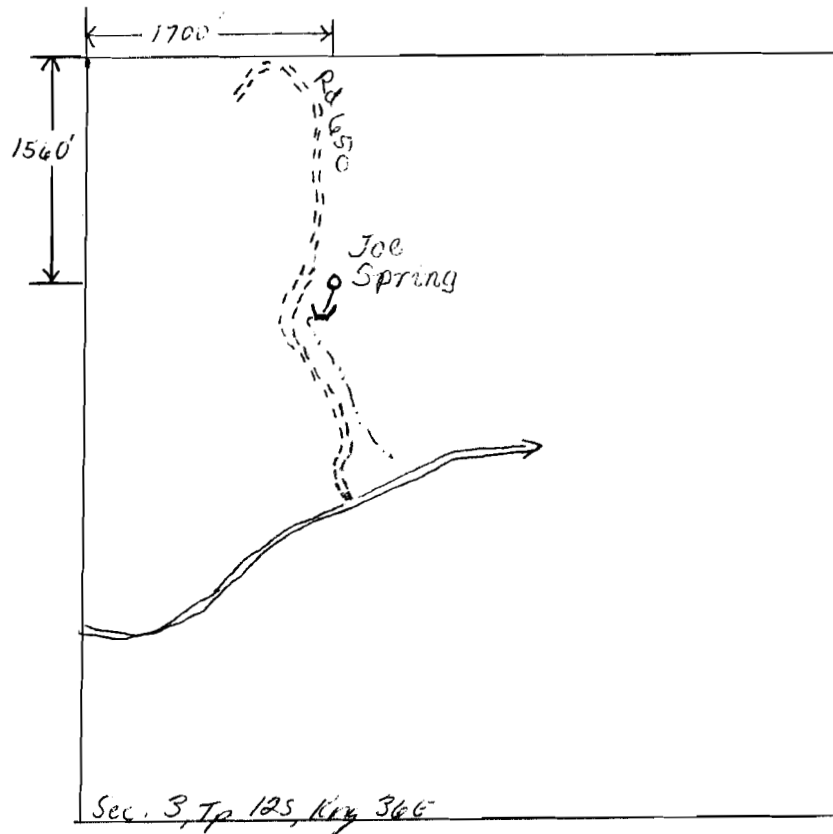

4" = 1 MILE

N ↑

RECEIVED

SEP 29 1982

WATER RESOURCES DEPT.
SALEM, OREGON