


Application No. 64215
Permit No. 49059

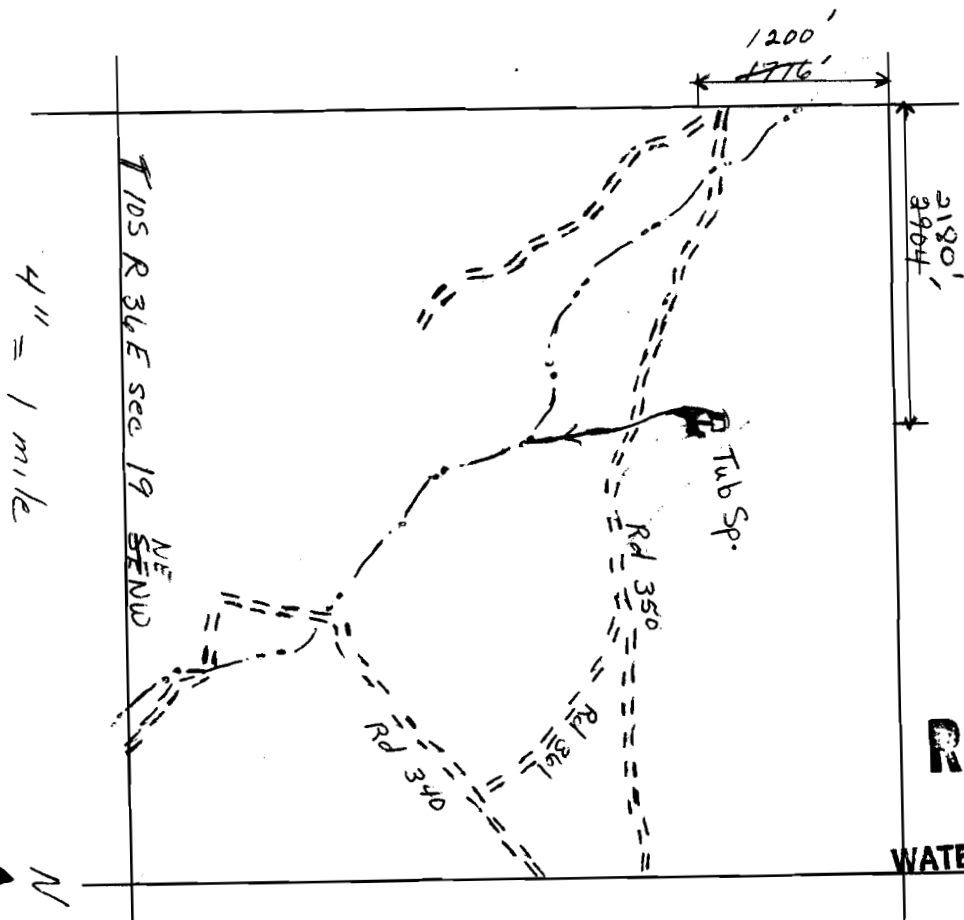

RECEIVED
JUN 24 1983
WATER RESOURCES DEPT.
SALEM, OREGON

RECEIVED
SEP 1 1983
WATER RESOURCES DEPT.
SALEM, OREGON

RECEIVED
SEP 29 1982
WATER RESOURCES DEPT.
SALEM, OREGON