


T10S R36E Sec 18

Application No. 64216
Permit No. 49060

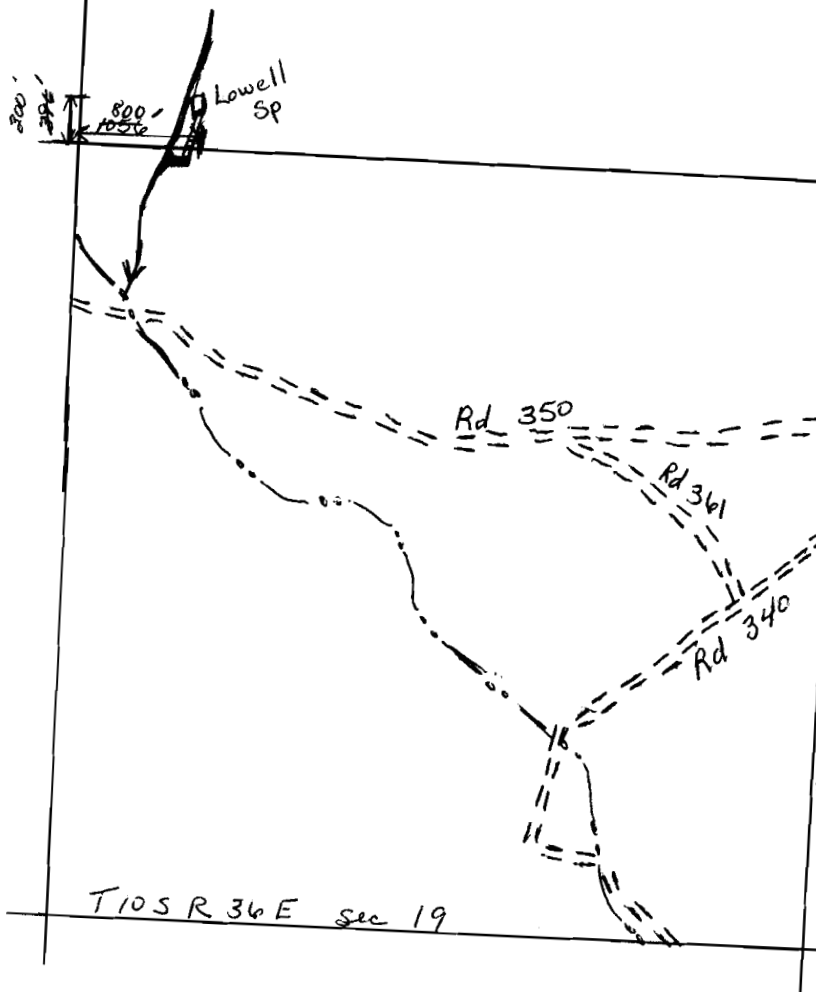

RECEIVED
JUN 24 1983
WATER RESOURCES DEPT.
SALEM, OREGON

4" = 1 mile

RECEIVED
SEP 29 1982
WATER RESOURCES DEPT.
SALEM, OREGON

