


RECEIVED
JUN 24 1983
WATER RESOURCES DEPT.
SALEM, OREGON

RECEIVED
SEP 29 1982
WATER RESOURCES DEPT.
SALEM, OREGON

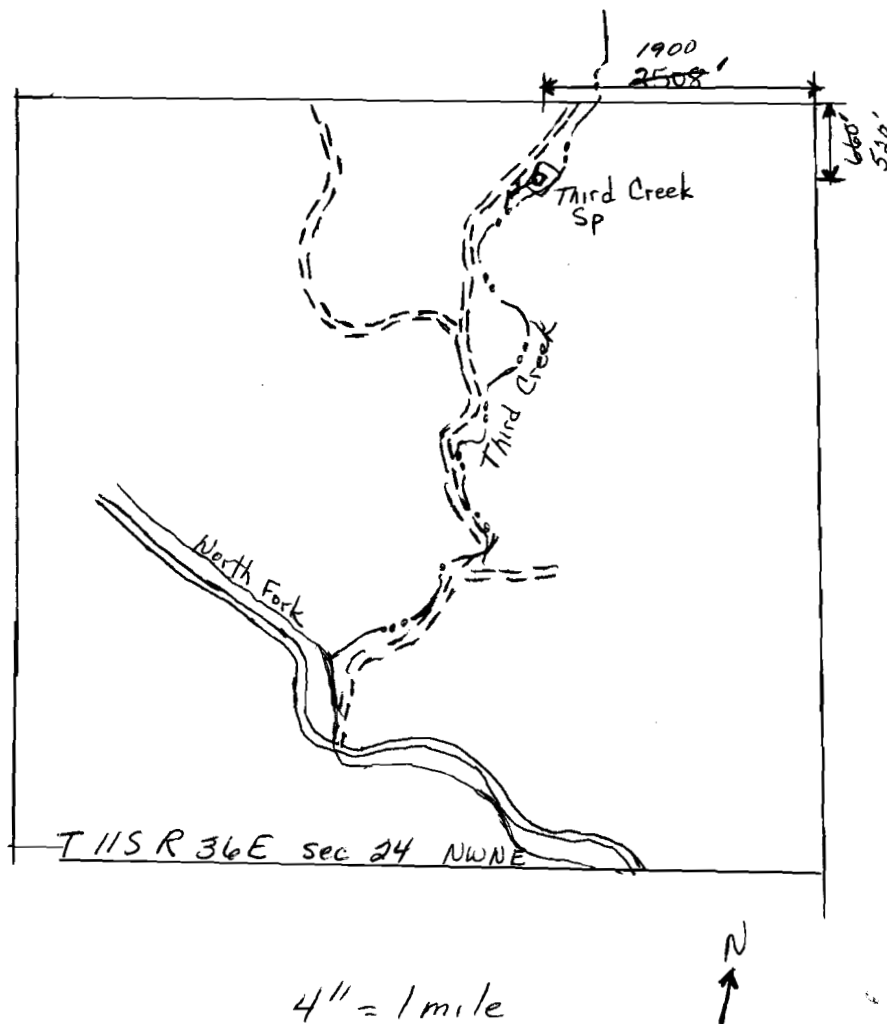

Application No. 64217
Permit No. 49061