


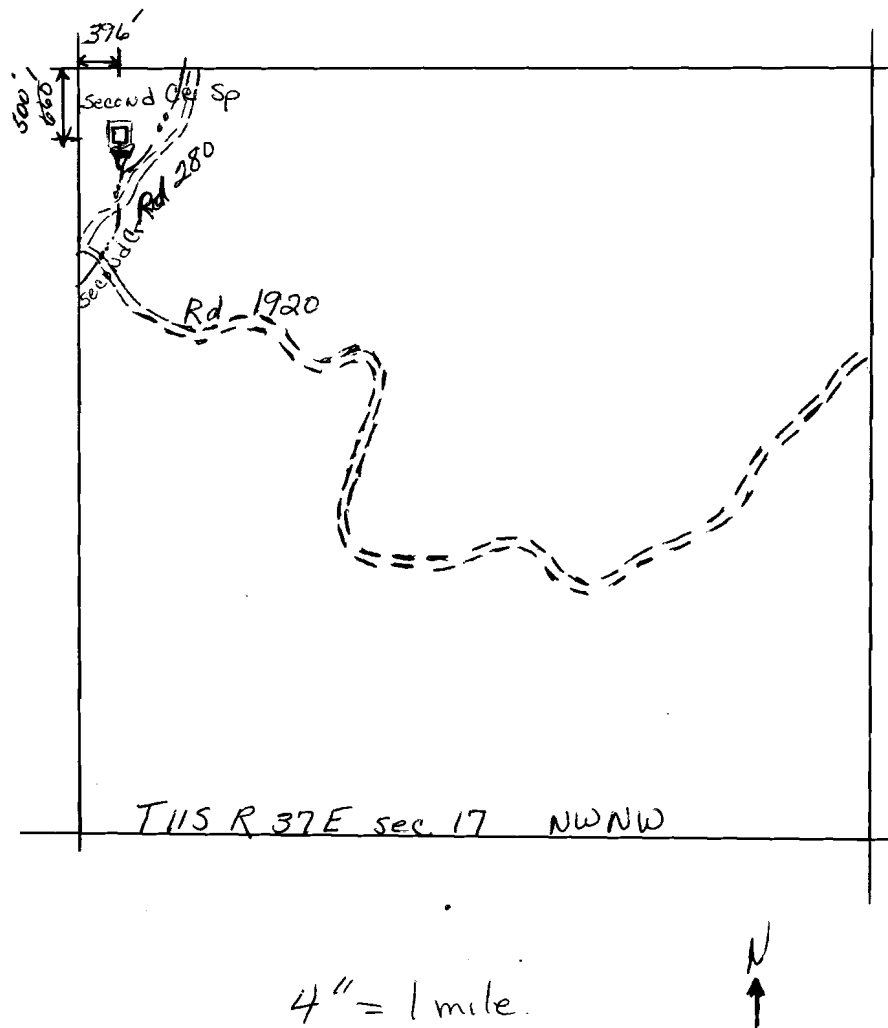

RECEIVED
SEP 29 1982
WATER RESOURCES DEPT.
SALEM, OREGON

RECEIVED
JUN 24 1983
WATER RESOURCES DEPT.
SALEM, OREGON

Application No. 64219
Permit No. 49063