


Application No. 64220
Permit No. 49064

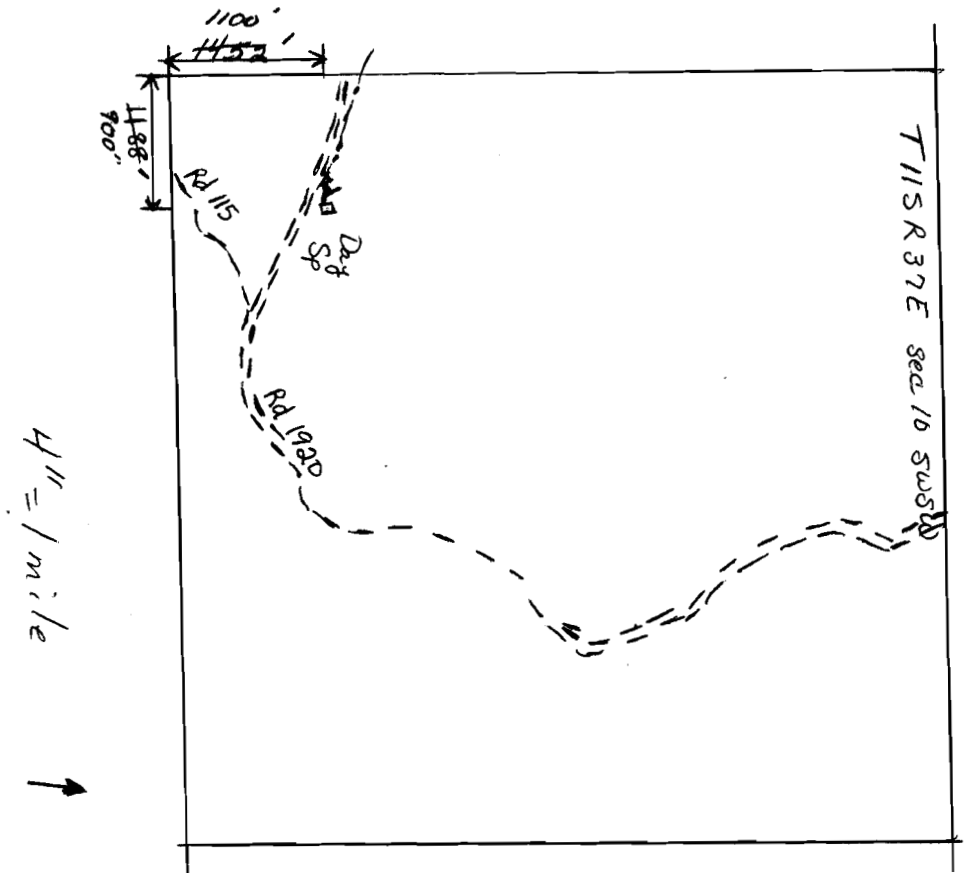

RECEIVED

JUN 24 1983

WATER RESOURCES DEPT.
SALEM, OREGON

RECEIVED

SEP 29 1982

WATER RESOURCES DEPT.
SALEM, OREGON