


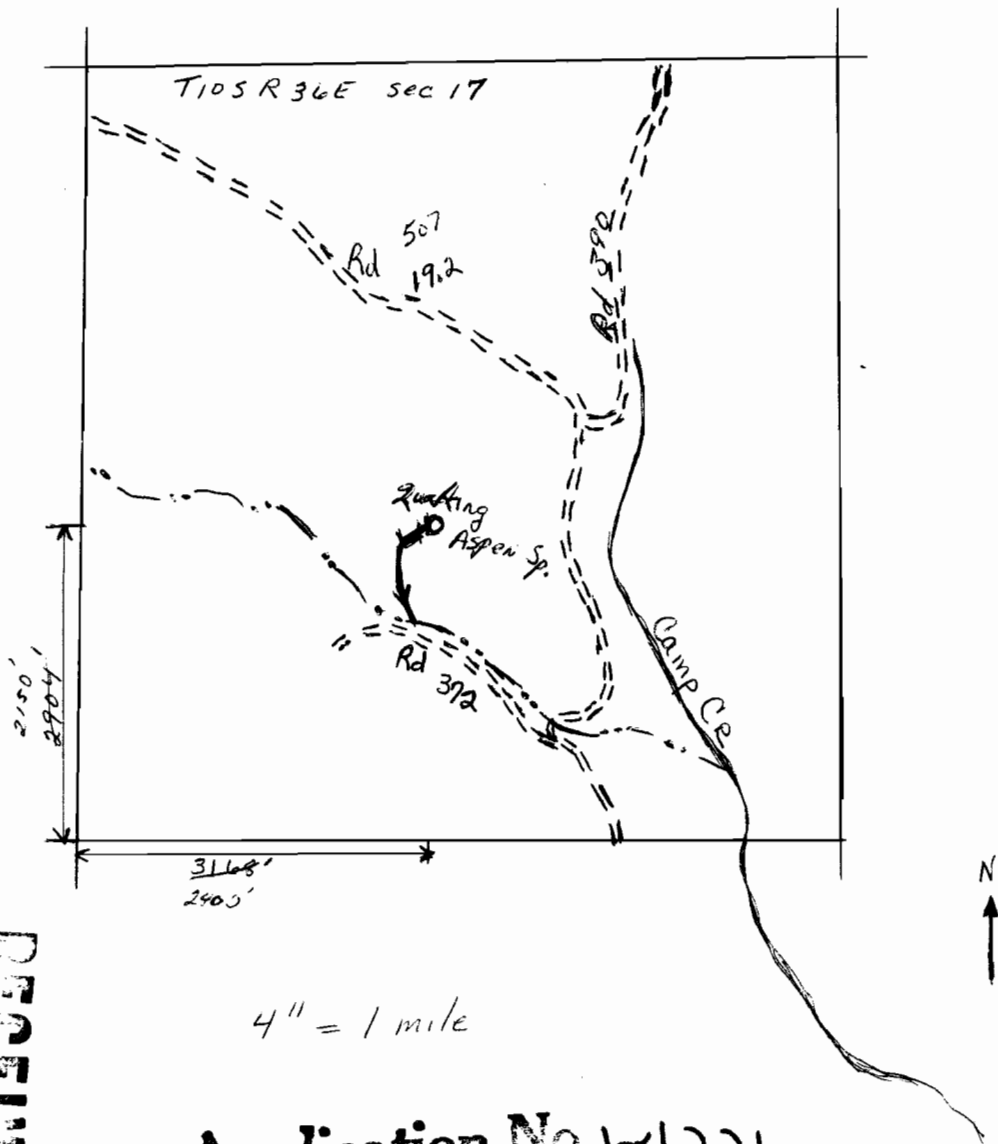

Application No. 64221
Permit No. 49065

RECEIVED

JUN 24 1983

WATER RESOURCES DEPT.
SALEM, OREGON

RECEIVED

SEP 29 1982

WATER RESOURCES DEPT.
SALEM, OREGON